
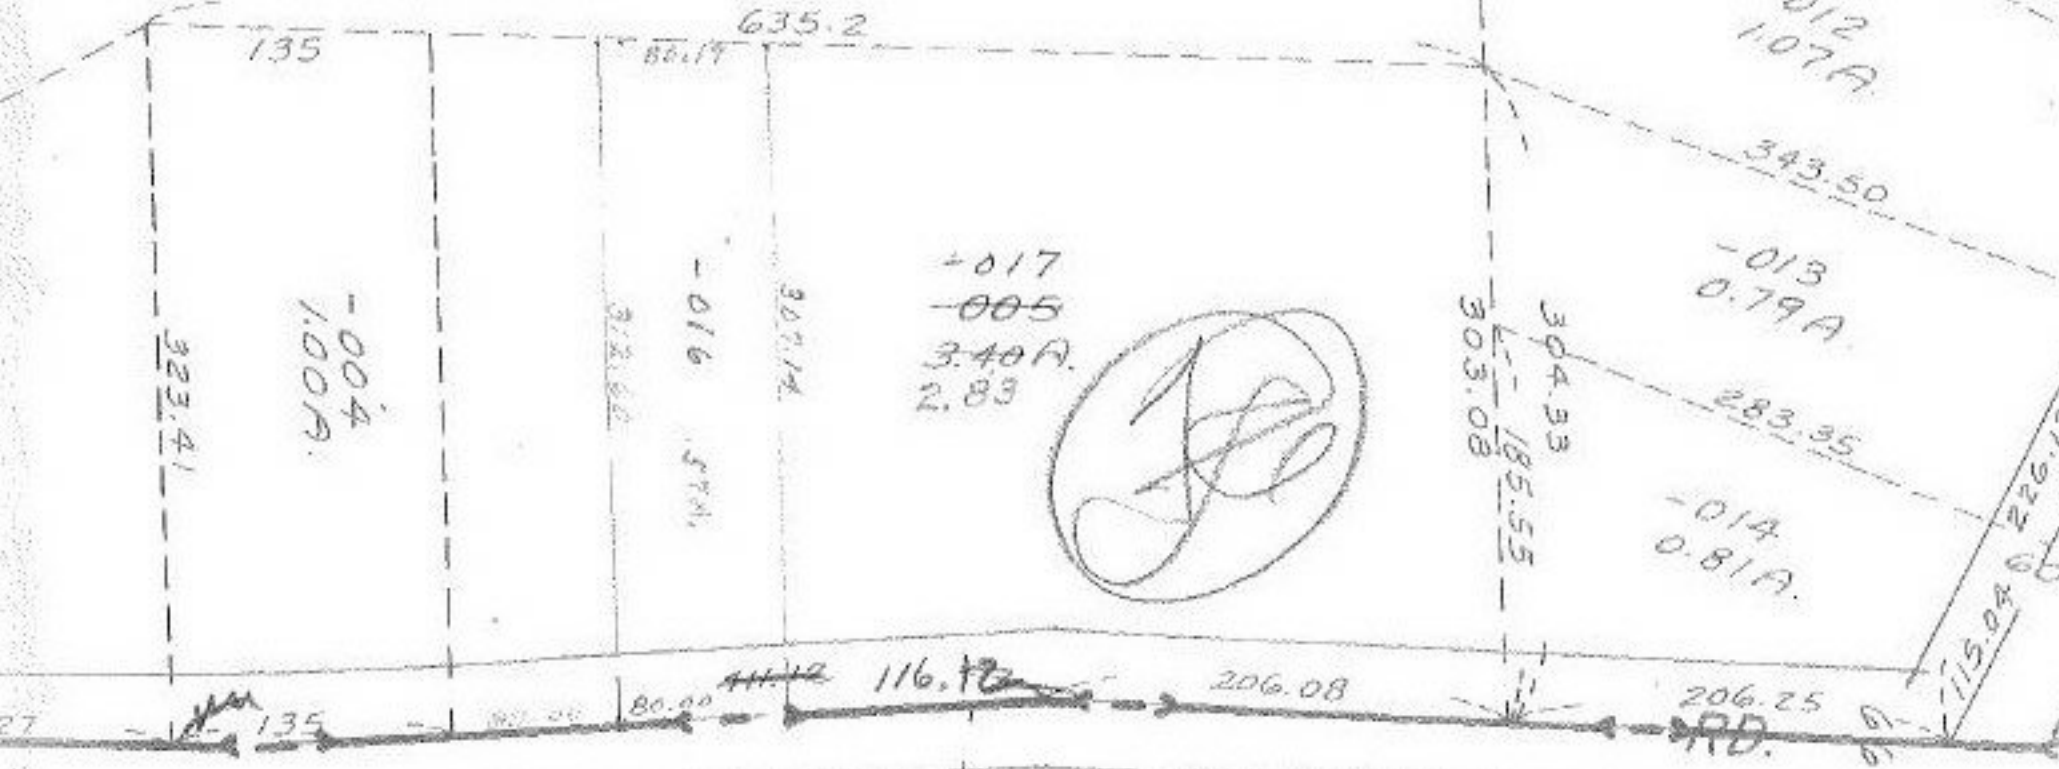


4559
JAN 27 ENTU

APPROVED
LORAIN CO.
MAP DEPT.
DATE 12/29/70
5-00-097-A
BY
R. J. [Signature]

7-17-86
L.L.

101

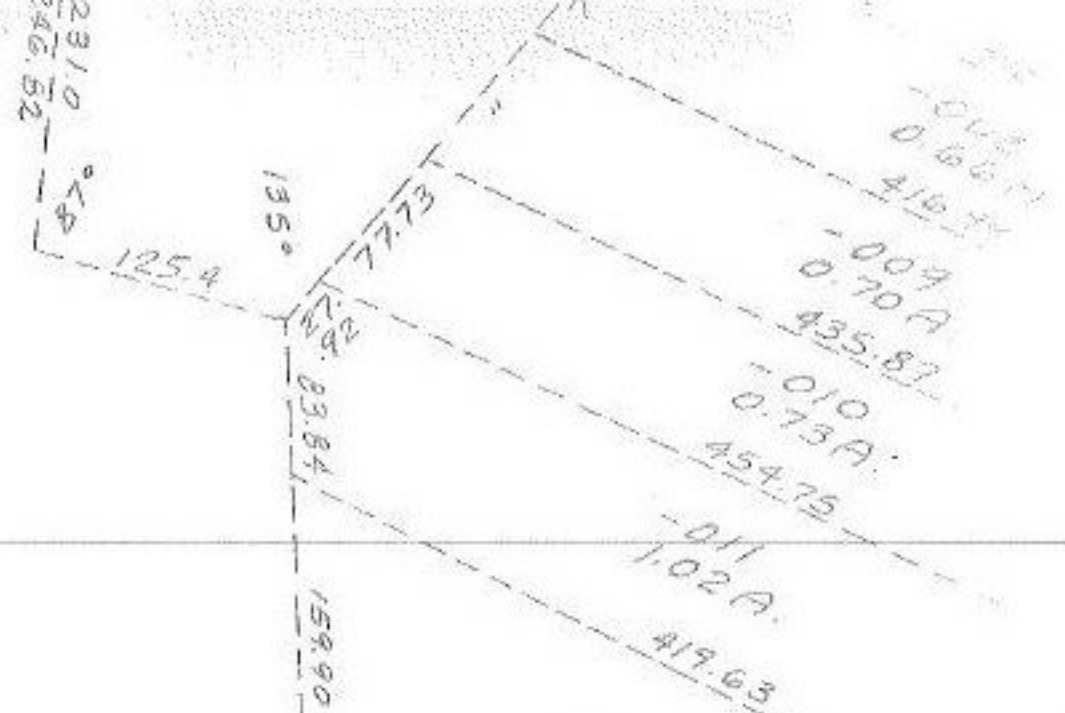

-017
-005
3.40 A
2.83

-013
0.79 A

-014
0.81 A

5-00-097-A
CROSSC
Z 1404559
4559