


4560

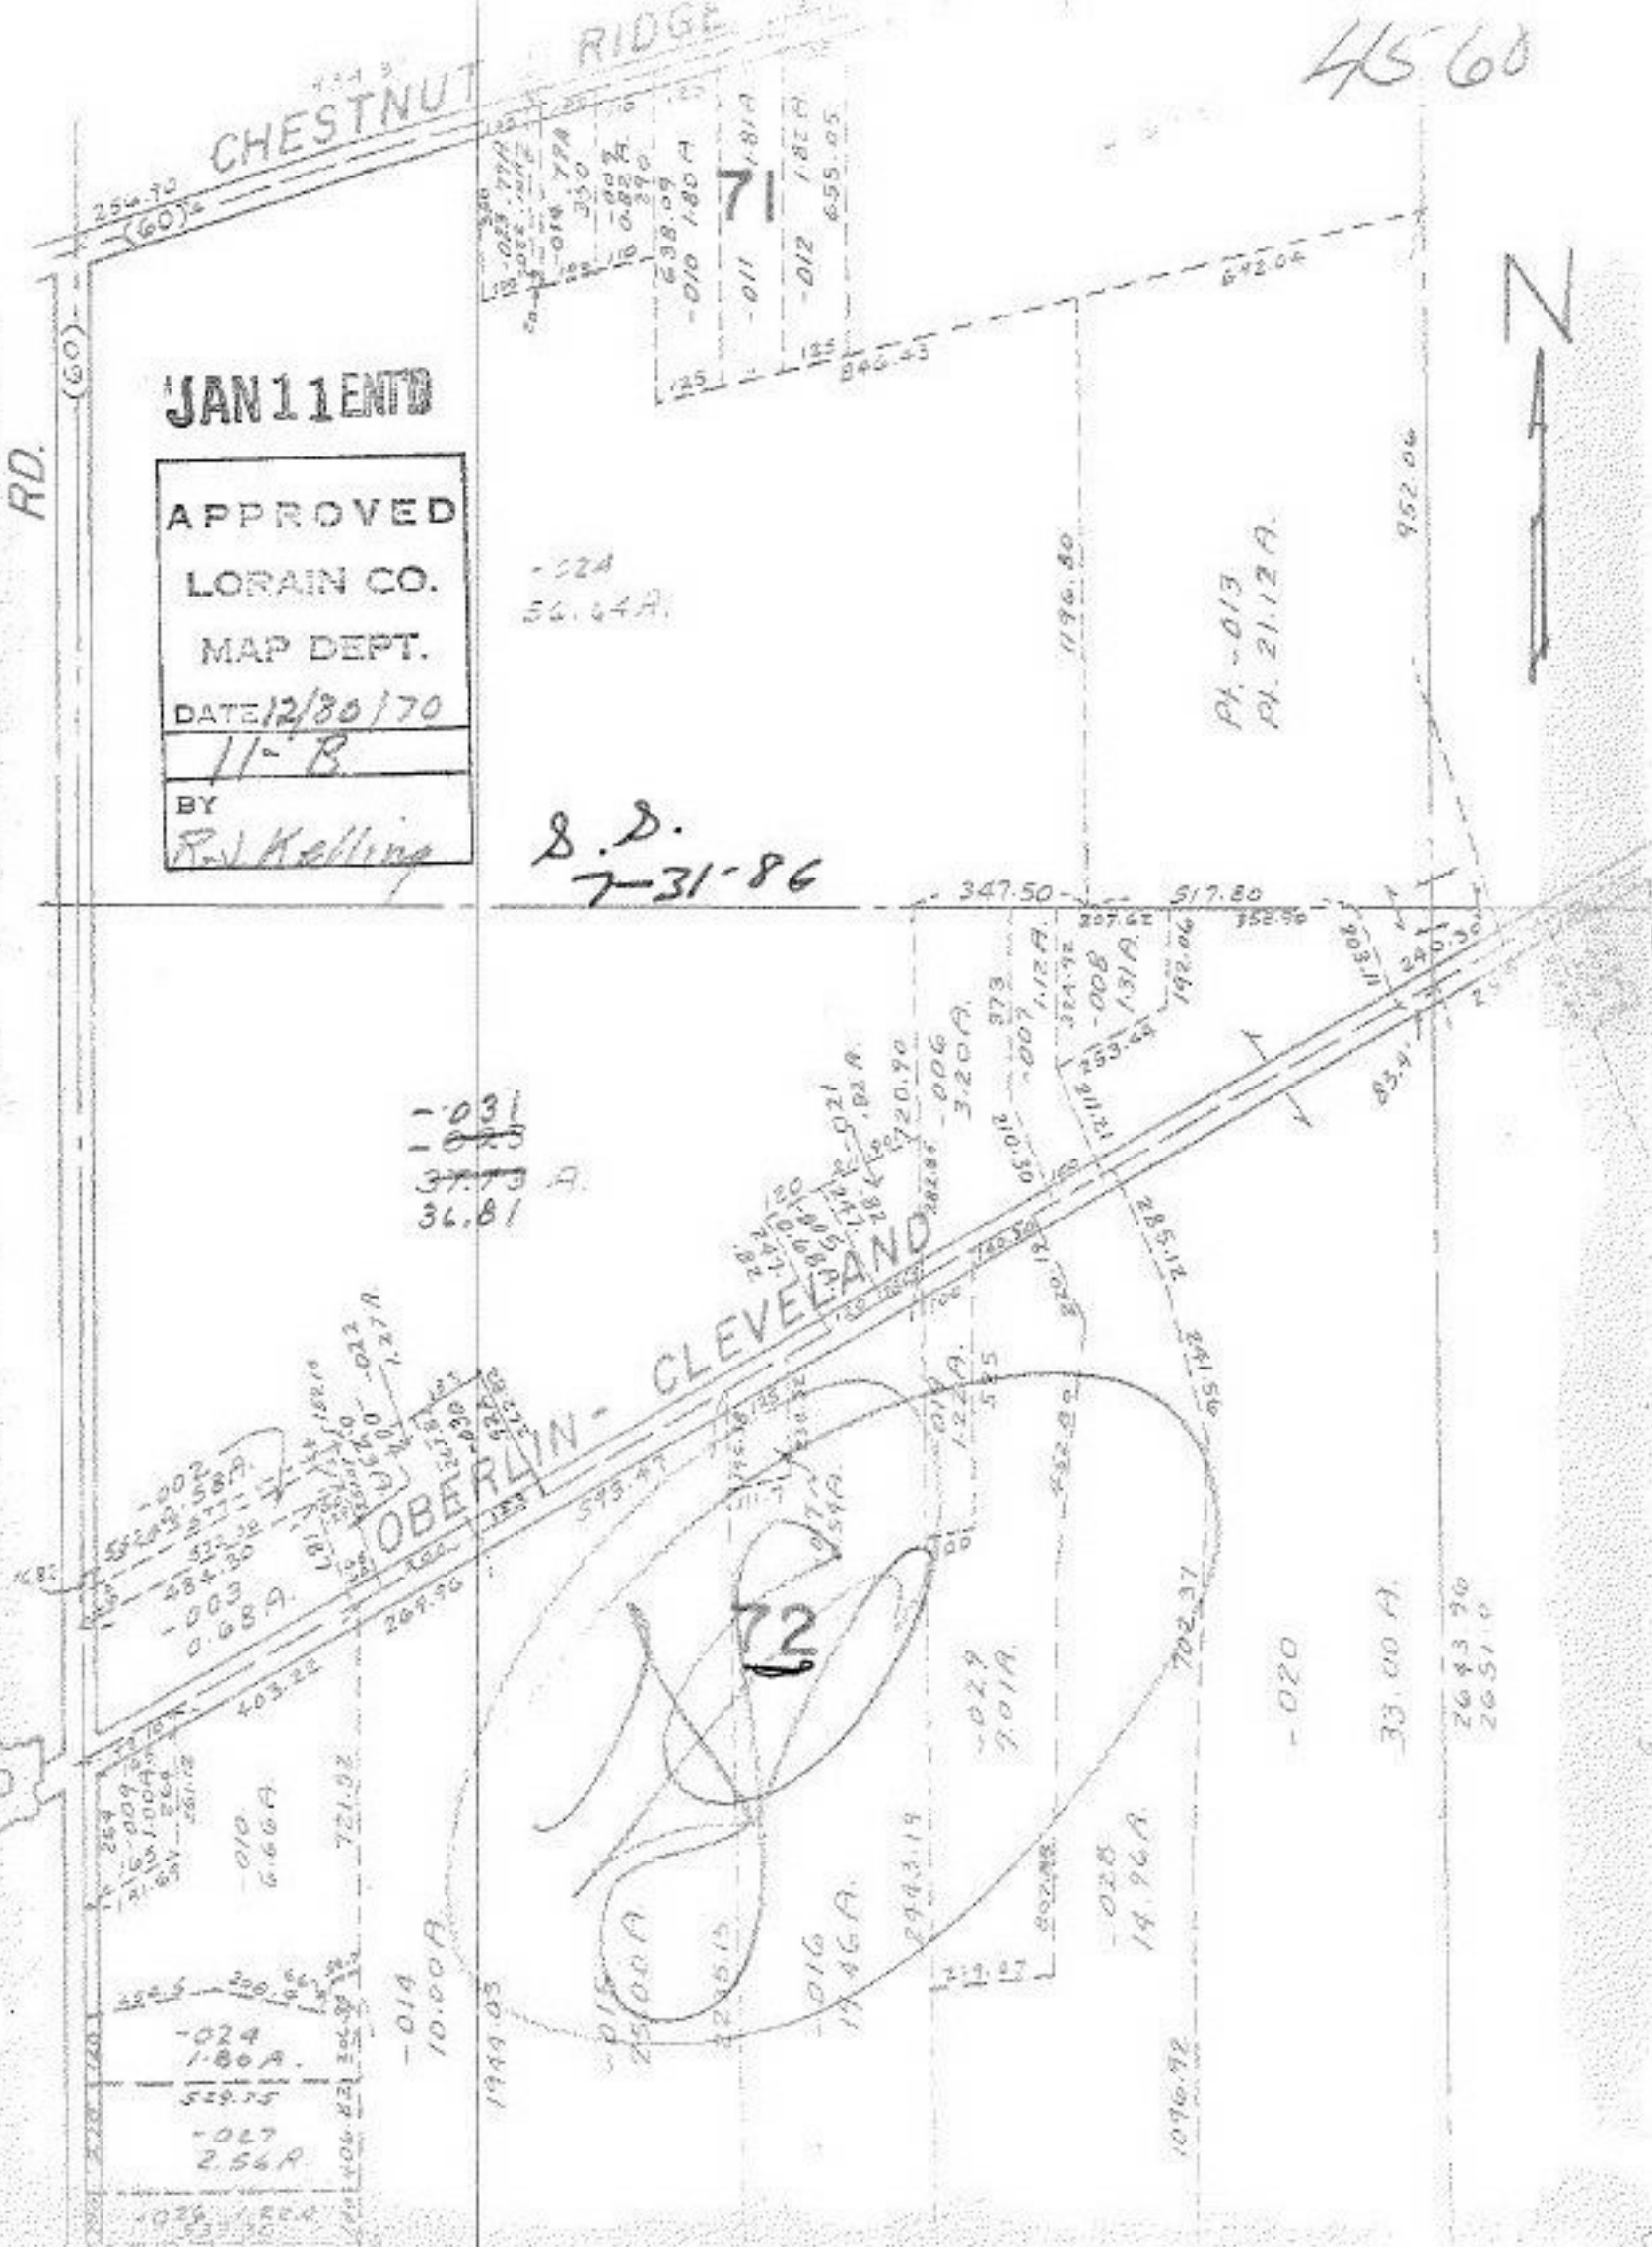

JAN 11 ENT'D

APPROVED  
 LORAIN CO.  
 MAP DEPT.  
 DATE 12/30/70  
 11-B  
 BY  
 R. J. Kelling

S.D.  
7-31-86



10