


4588
4588

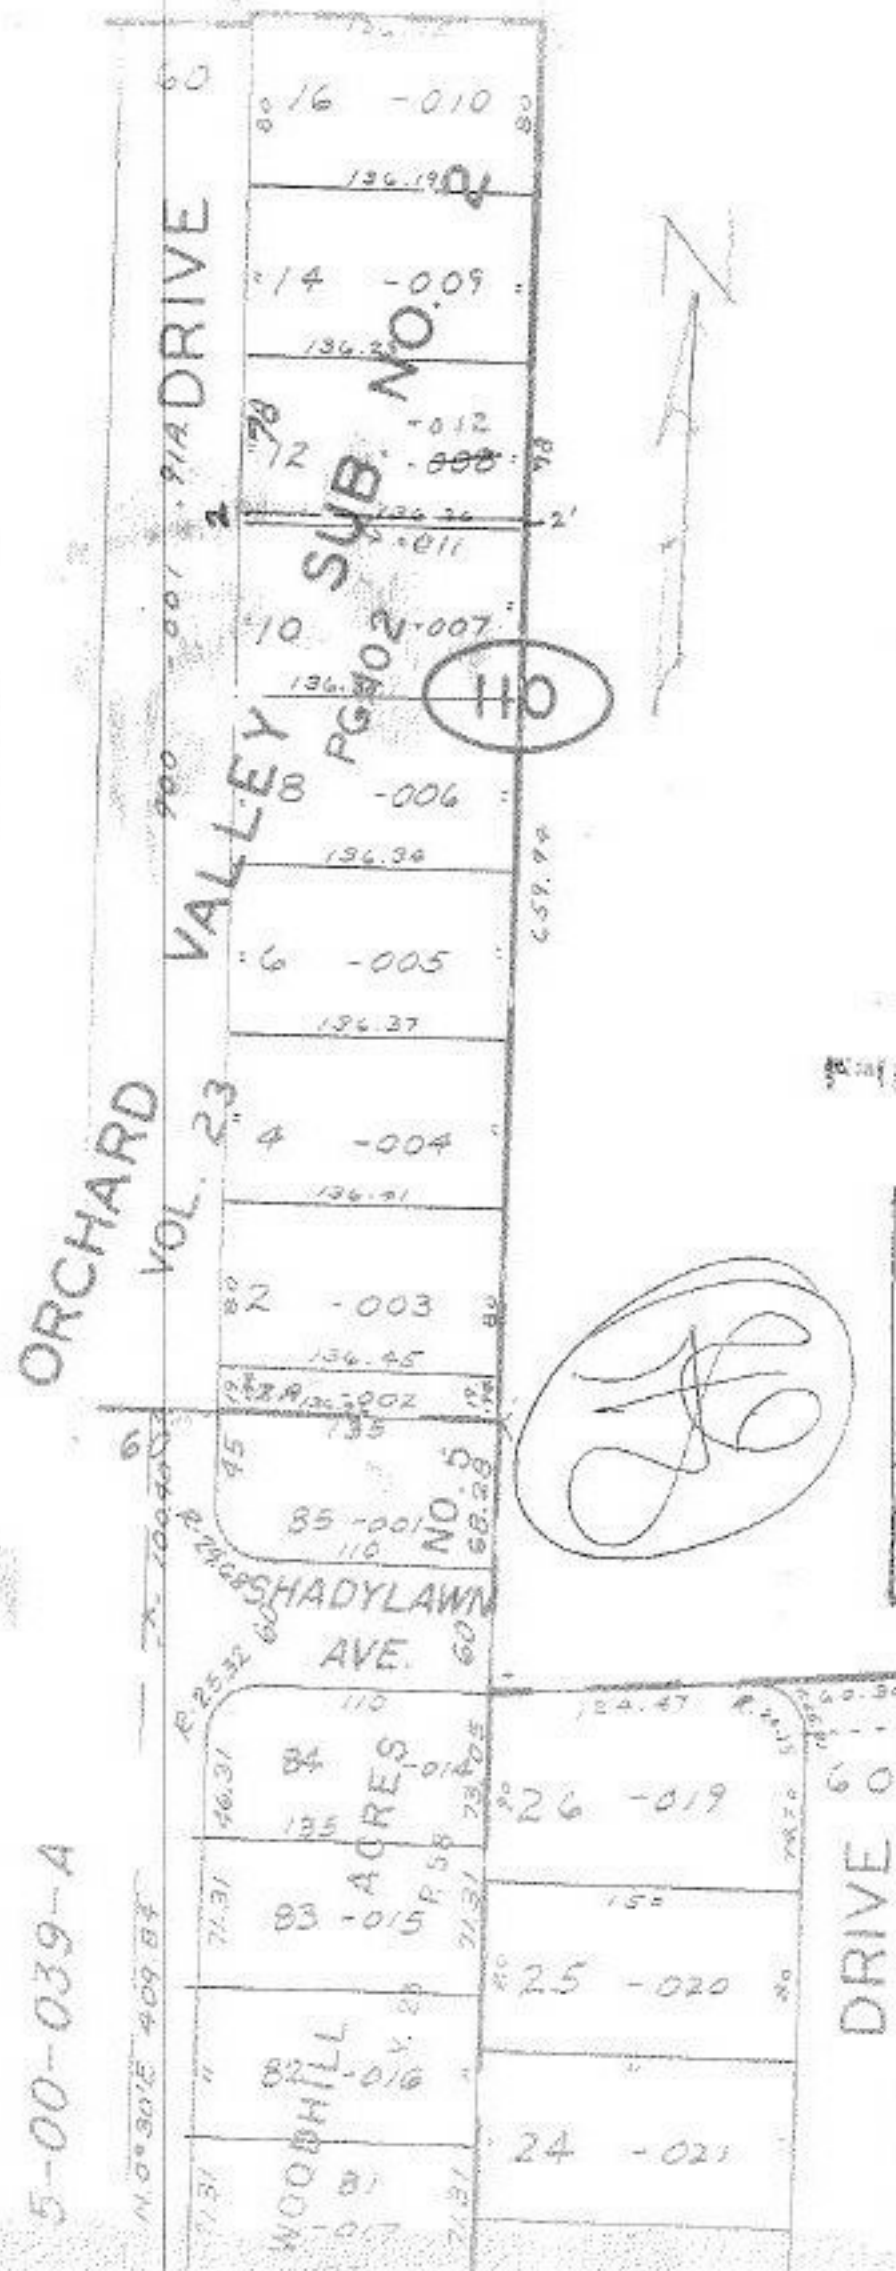

JAN 27 ENT'D

4588

APPROVED
LORAIN CO.
MAP DEPT.
DATE 1/18/71
BY R. J. Kelling

7-17-86 L.L.

ORCHARD
VOL. 23

5-00-039-A

5-00-039-B

DRIVE 60

NO 1