

Pl. 03-00-033-115
Pl. 8.24 A

109

877.74
877.93
877.93
002
73 A

JAN 27 ENT'D

115 93
APPROVED
LORAIN CO.
MAP DEPT.
DATE 1-20-71
3-00-033 A
BY L W Hall

3275.30

3318.28

3360.72

3402.63

117.79


COVE BEACH

RD.

HART AVE.

B

4593

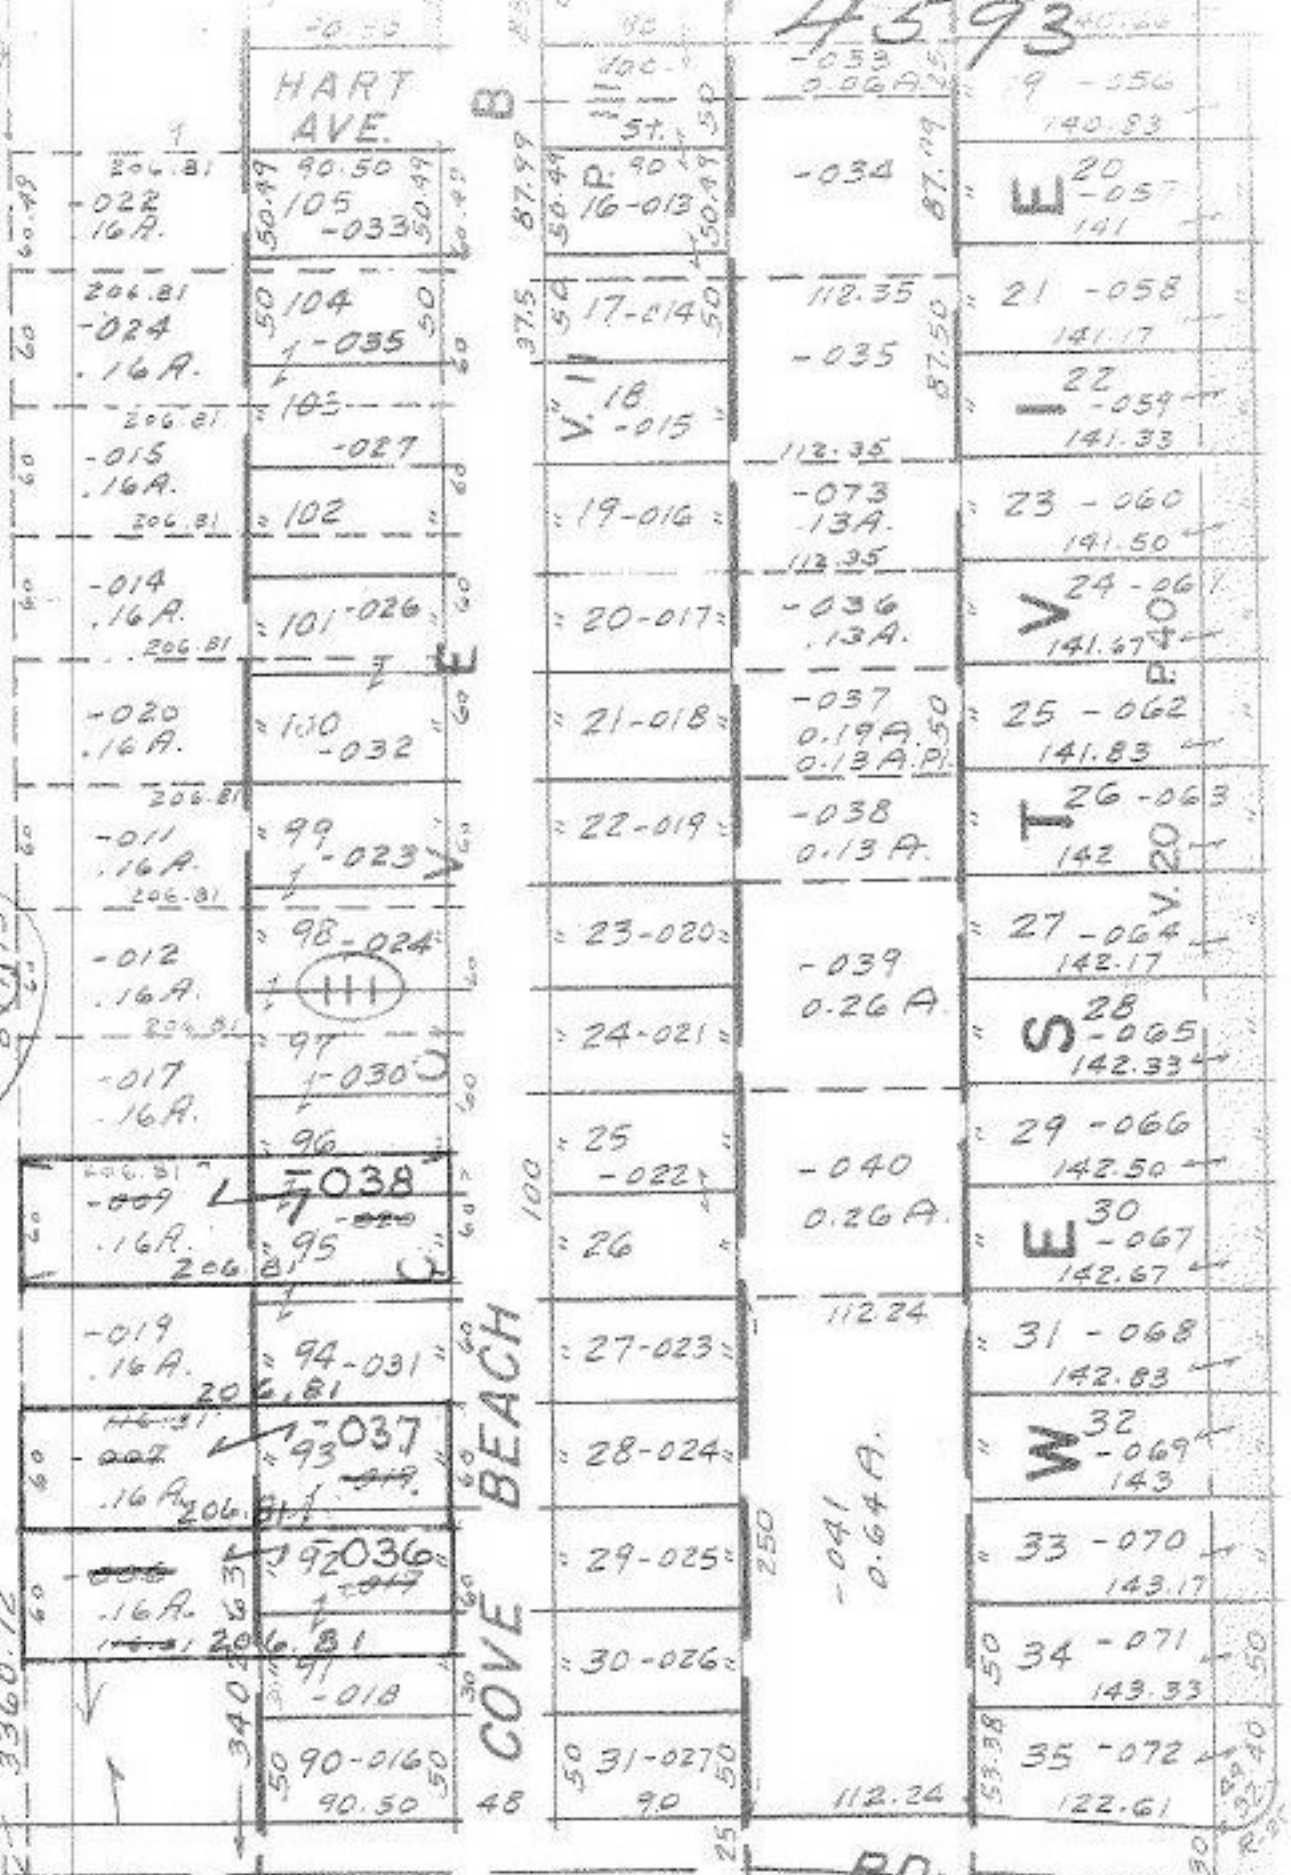

SEE 3-00-033-B

Note P P Nos 036-037-038 Designated as being in Block 111

3-00-033 A