


4595

APPROVED  
LORAIN CO.  
MAP DEPT.  
DATE 1/20/71  
16-G  
BY R.V. Kelling

JAN 26 ENT'D

16-00-066-000-007

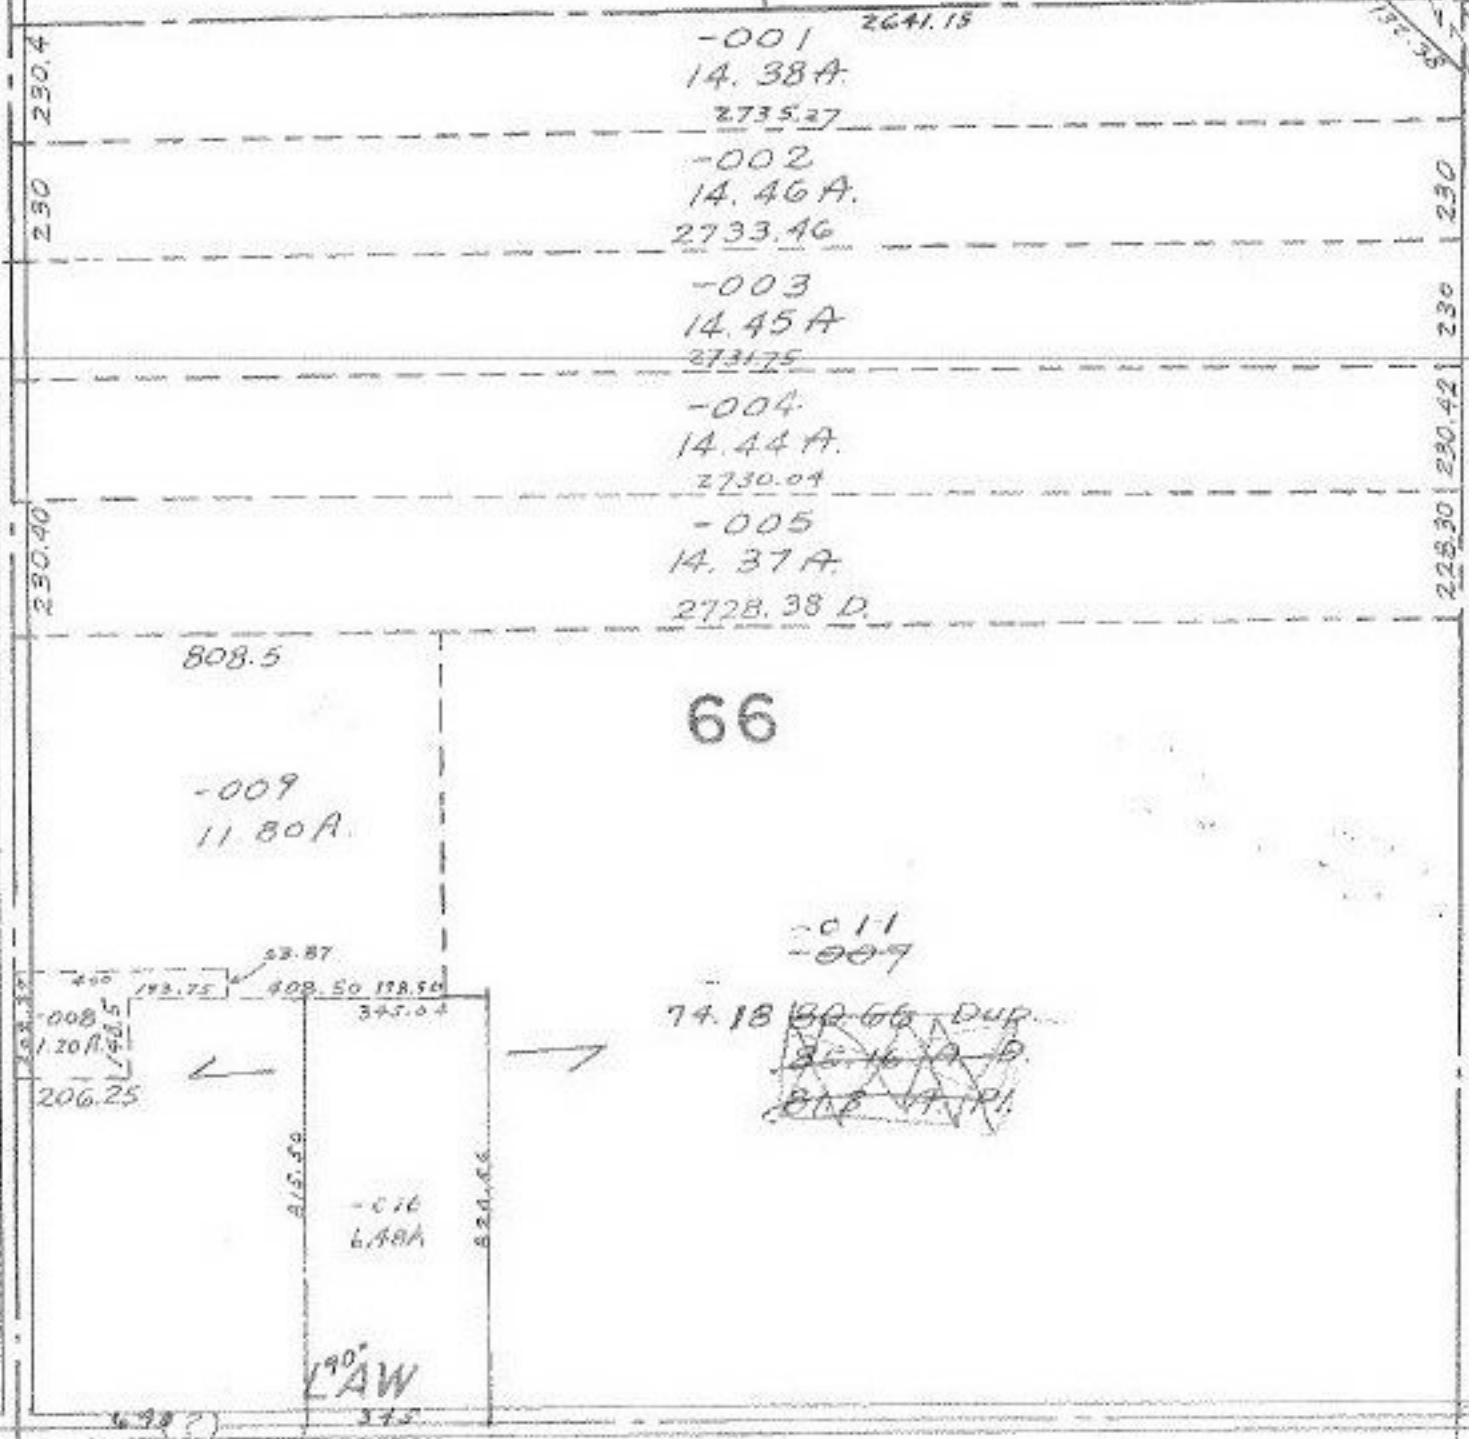

-001  
20.00 A

4595