


4596

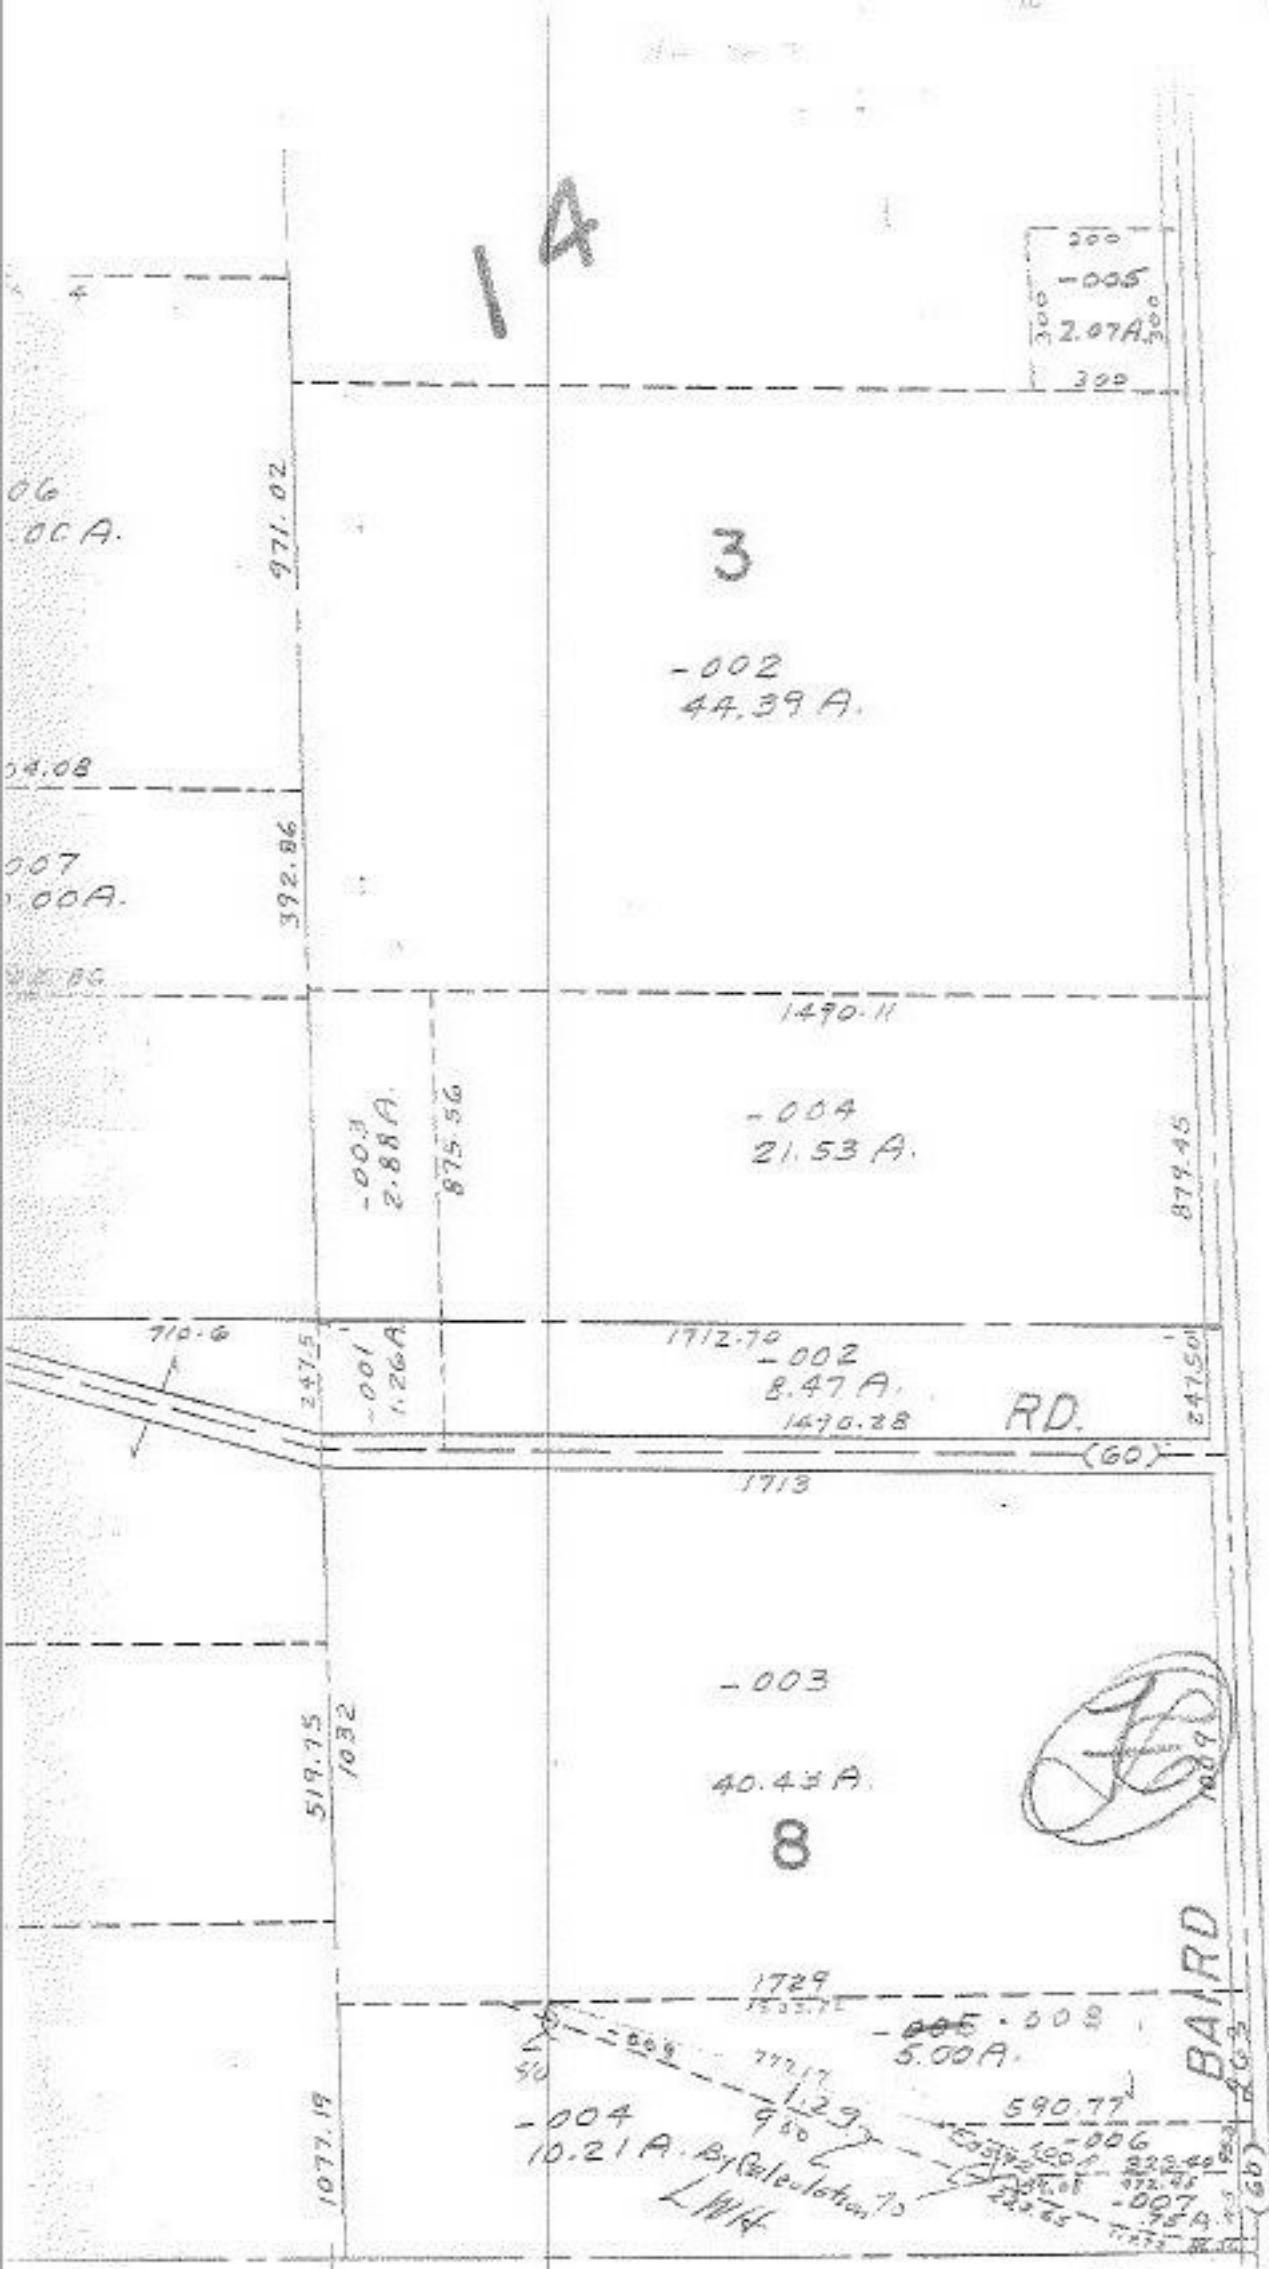

~~JAN 27 ENT'D~~

4596

APPROVED
LORAIN CO.
MAP DEPT.
DATE 1/20/71
BA
BY Paul Kelling