


109

4608

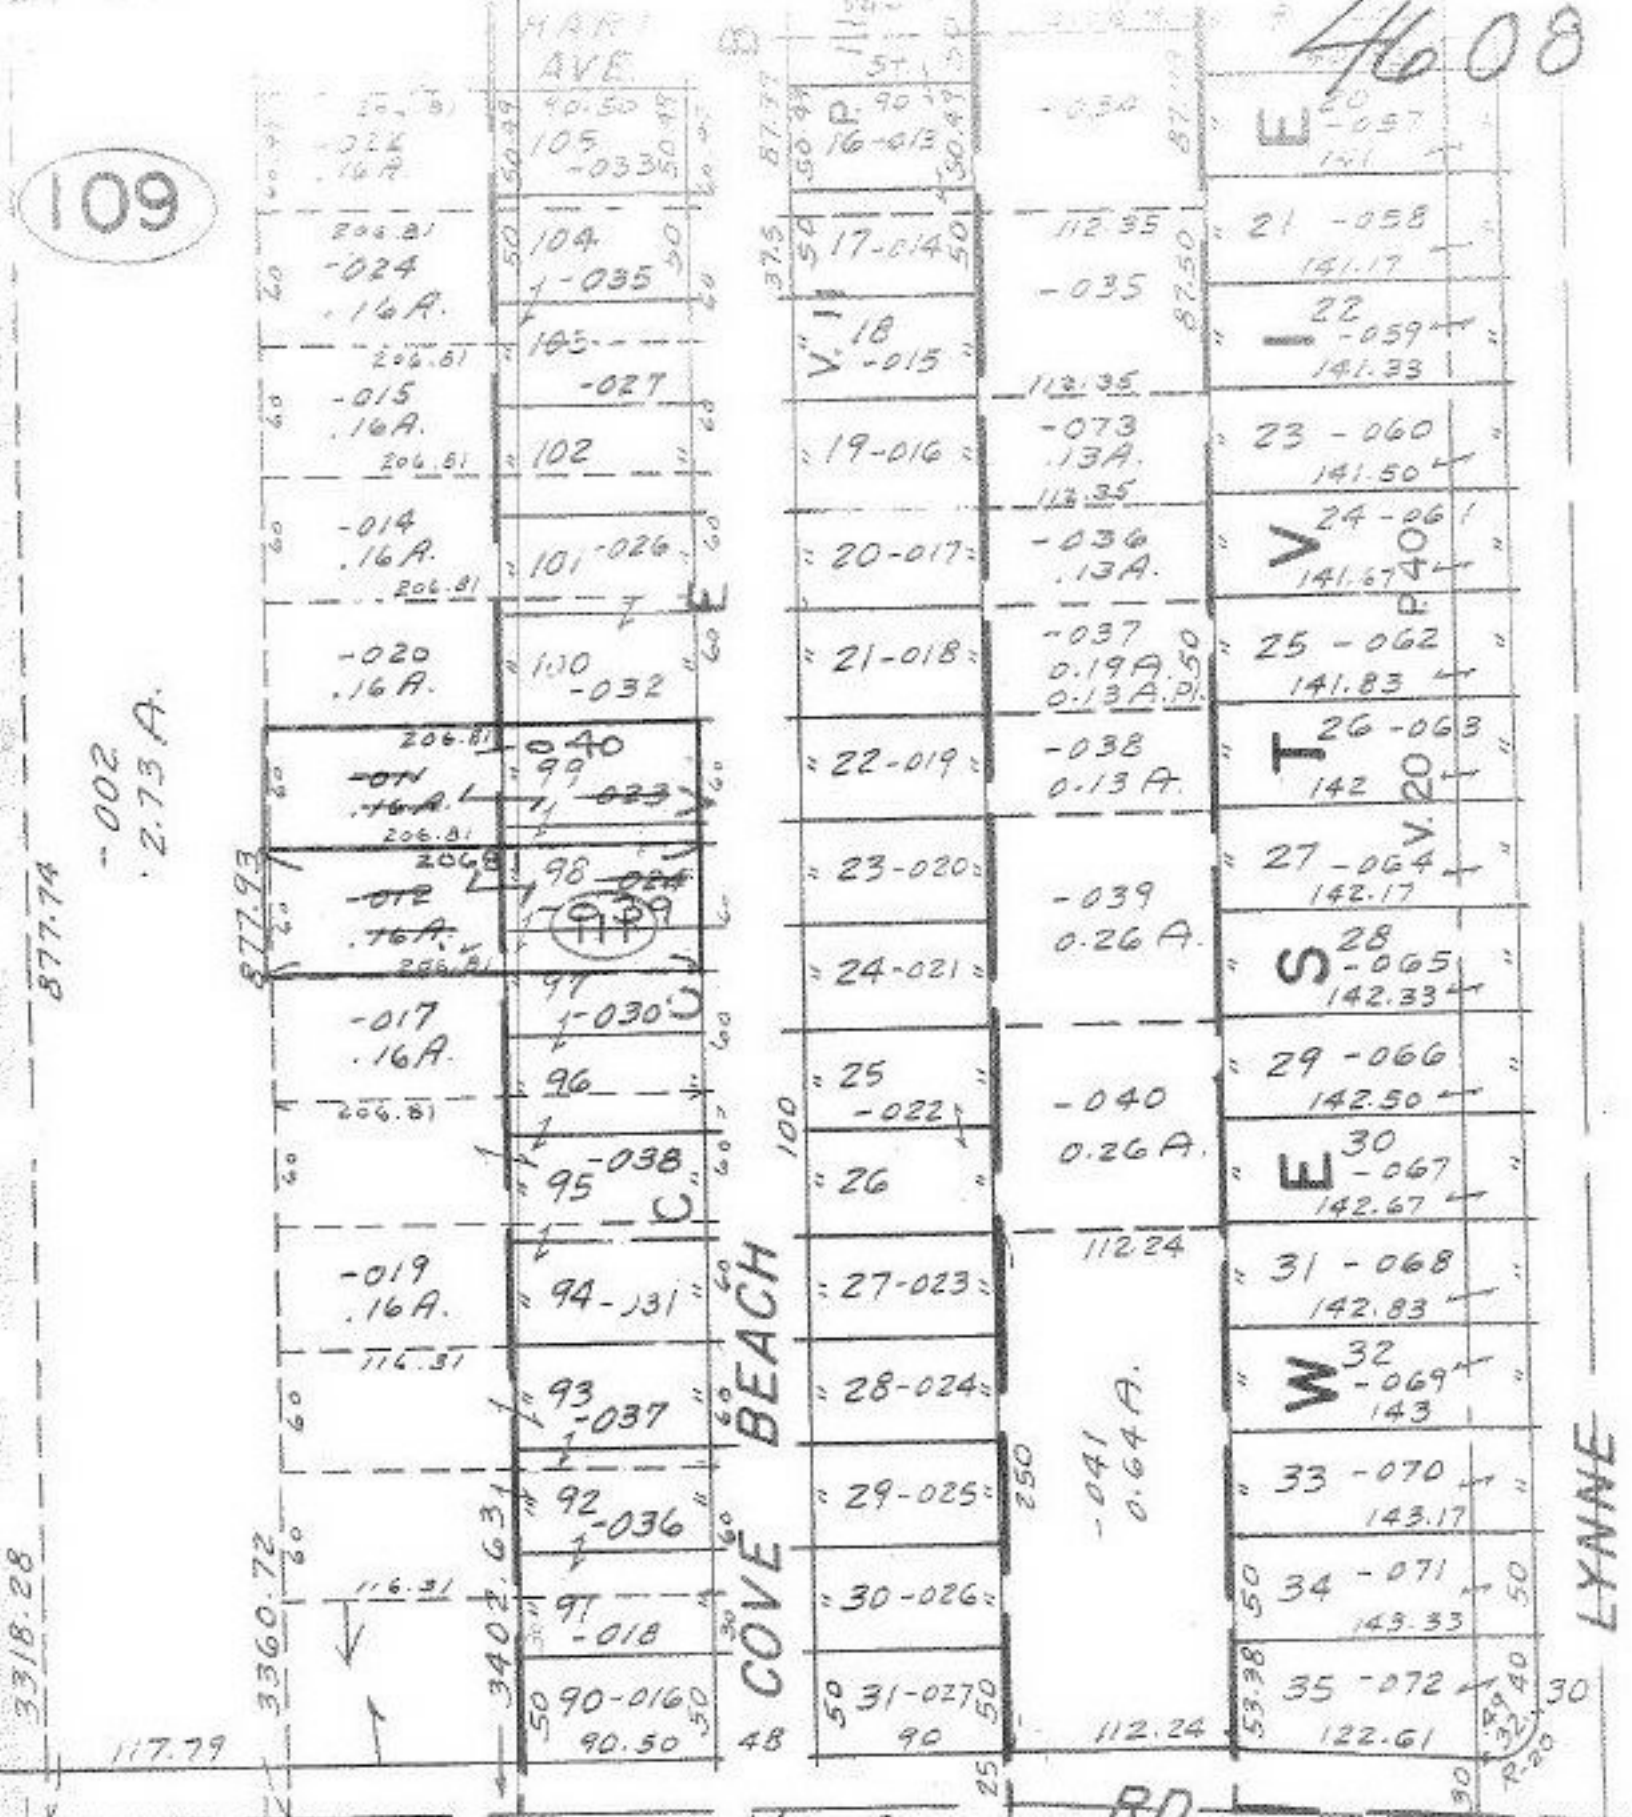

SEE 3-00-033-B

FEB 17 1970

4608  
 APPROVED  
 LORAIN CO.  
 MAP DEPT.  
 DATE 1-26-71  
 3-00-033A  
 BY LWHall



3-00-033A