

5/6 28

7-17-98-L1-L


APPROVED
LOGAN CO.
MAP DEPT.
DATE: 2/71
7/00-021-D
BY: R. L. Kelley

4628



237.12
 12.32
 124.80

FEB 18 1971

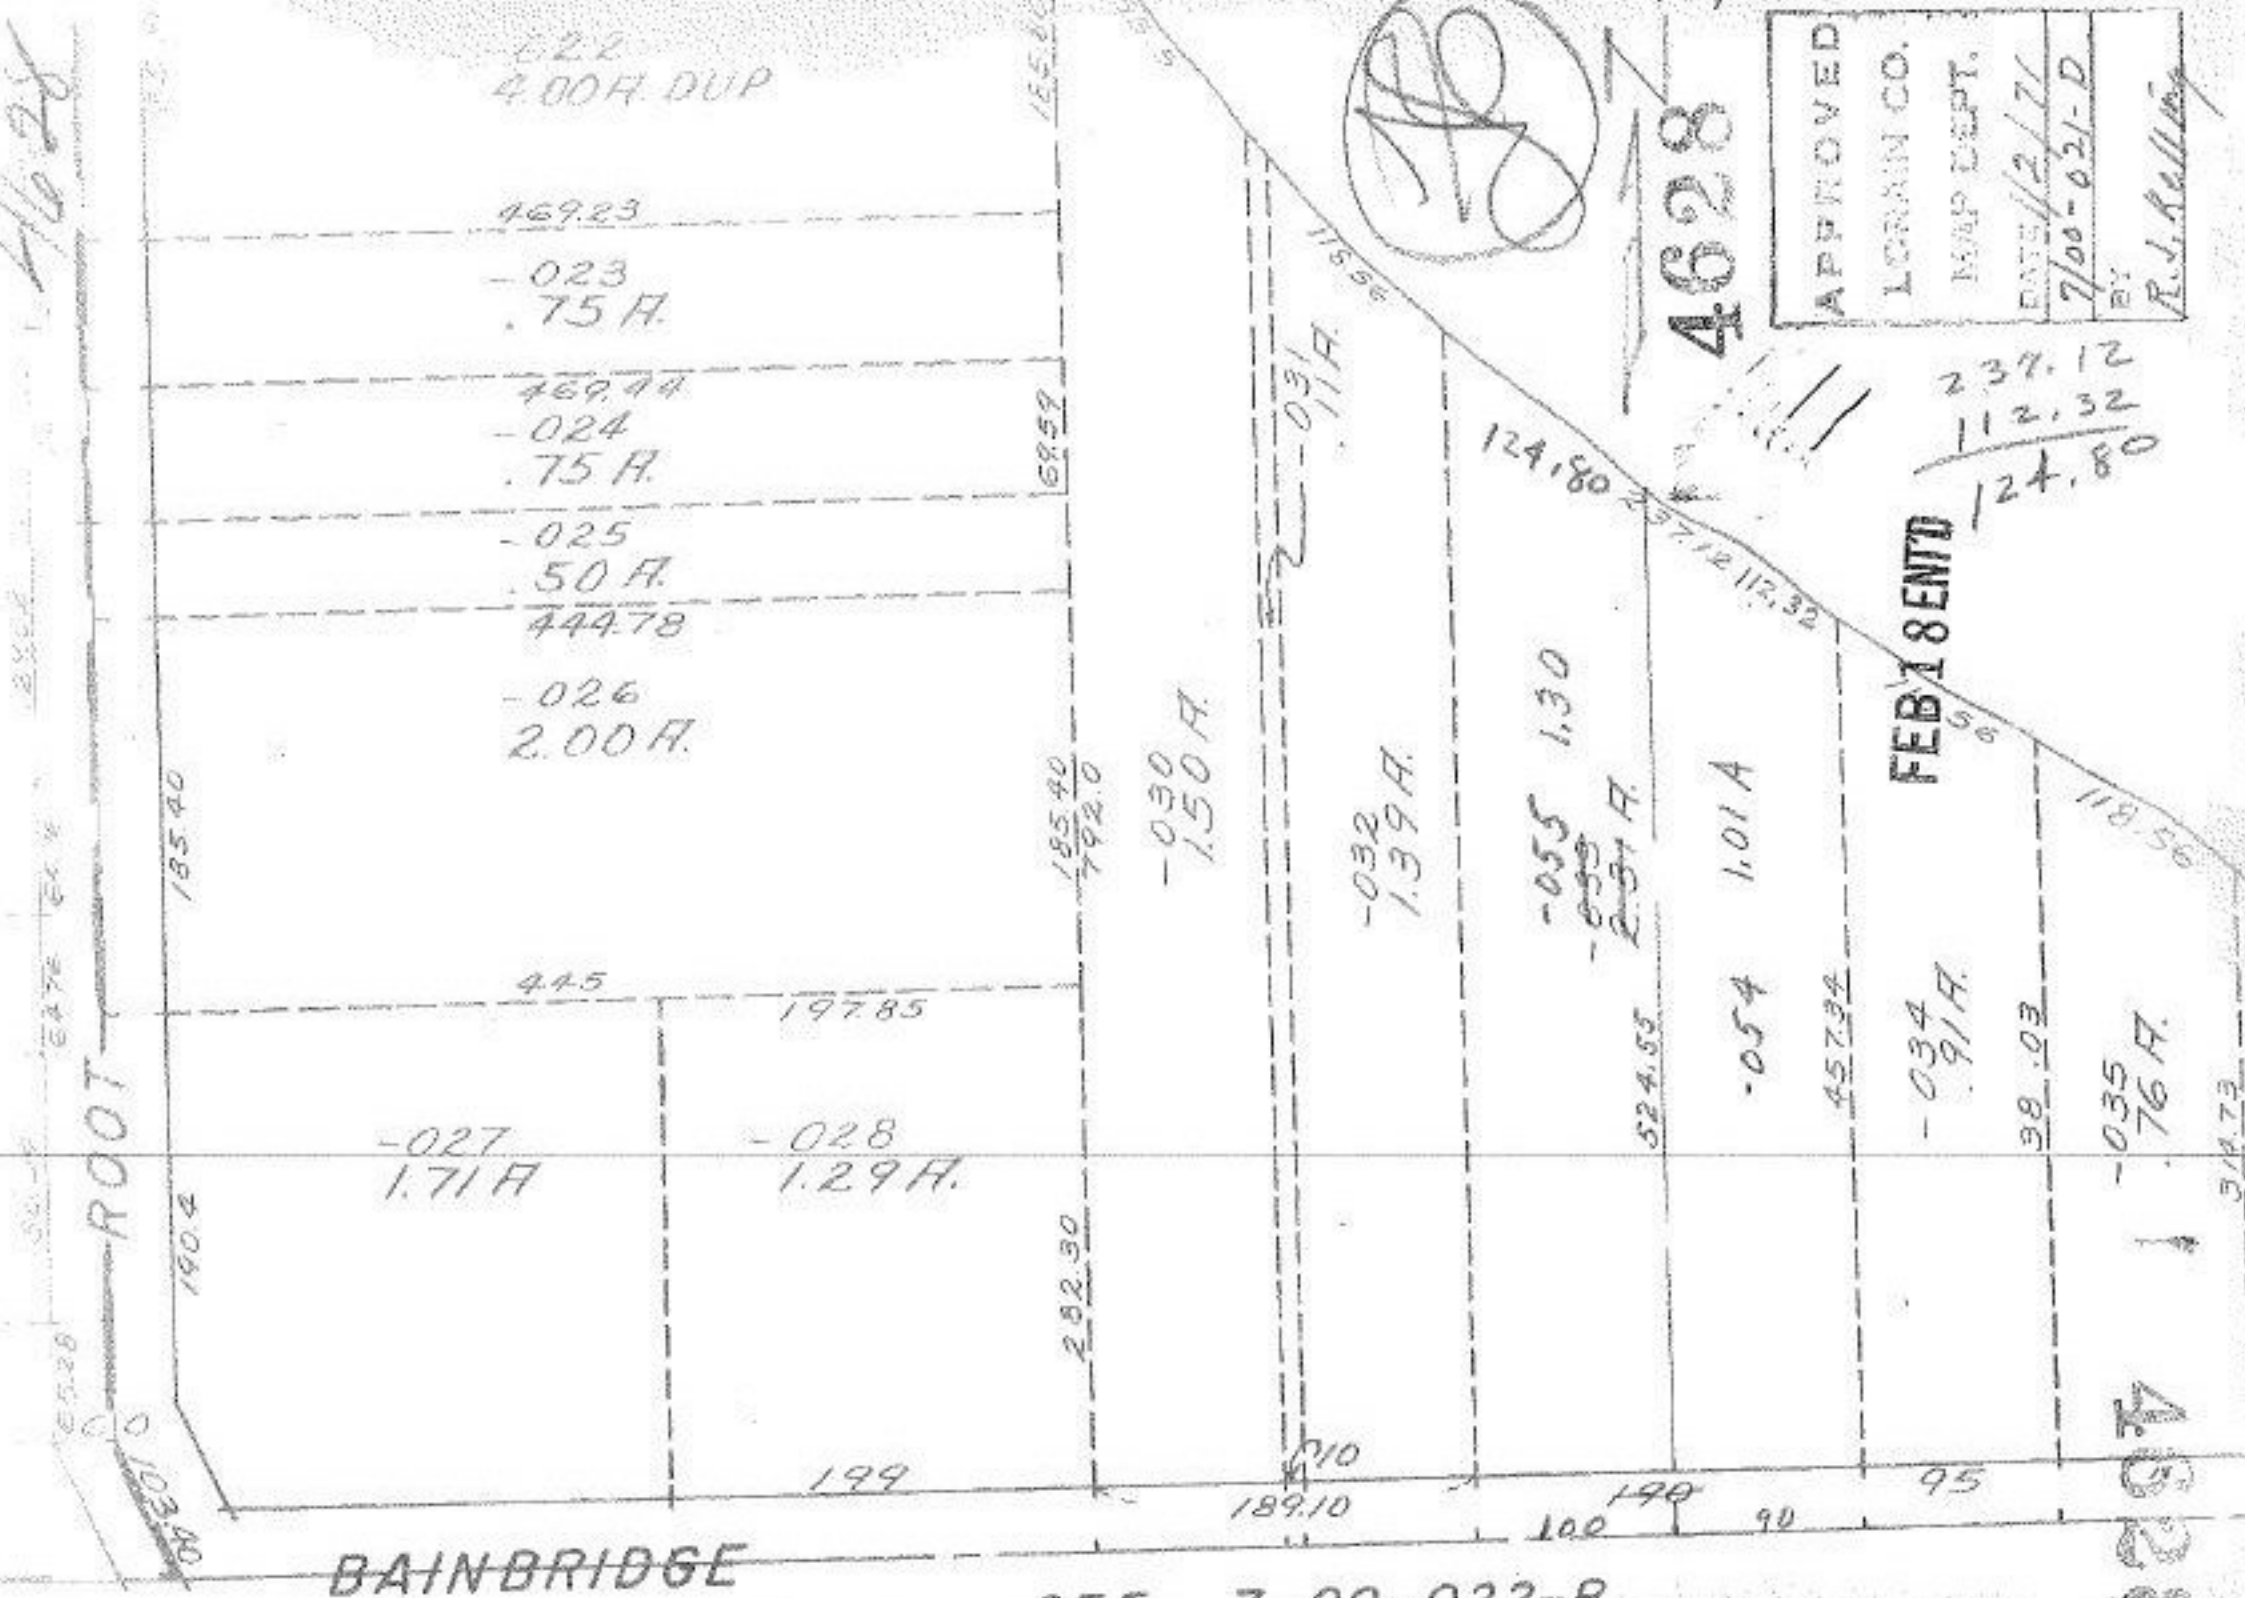

BAINBRIDGE

SEE 7-00-022-B

4628