

4646
4646

HASTINGS


-002
50A

4646

FEB 22 ENTD

APPROVED
 LORAIN CO.
 MAP DEPT.
 DATE 2/8/71
 18-00-020-5
 BY
 R. H. K. [Signature]

-033
1.08A

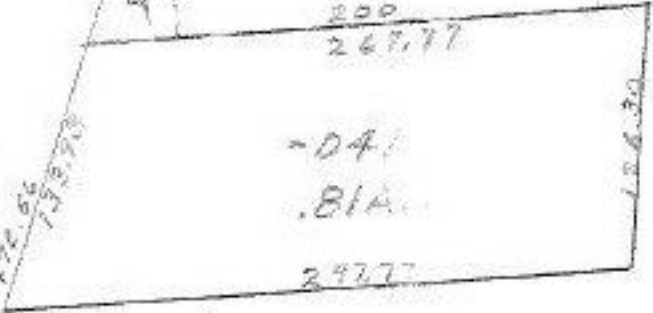

-042
57.95A



-034
.60A

-035
R.02

103

SEE 8-H

93.940
112.70

732

327.58

452

121.74

266.55
260.55

458.95

149.71

219.05

86.77

617.53

1601.84

.63A

—