


RI 4672

617  
150  
467

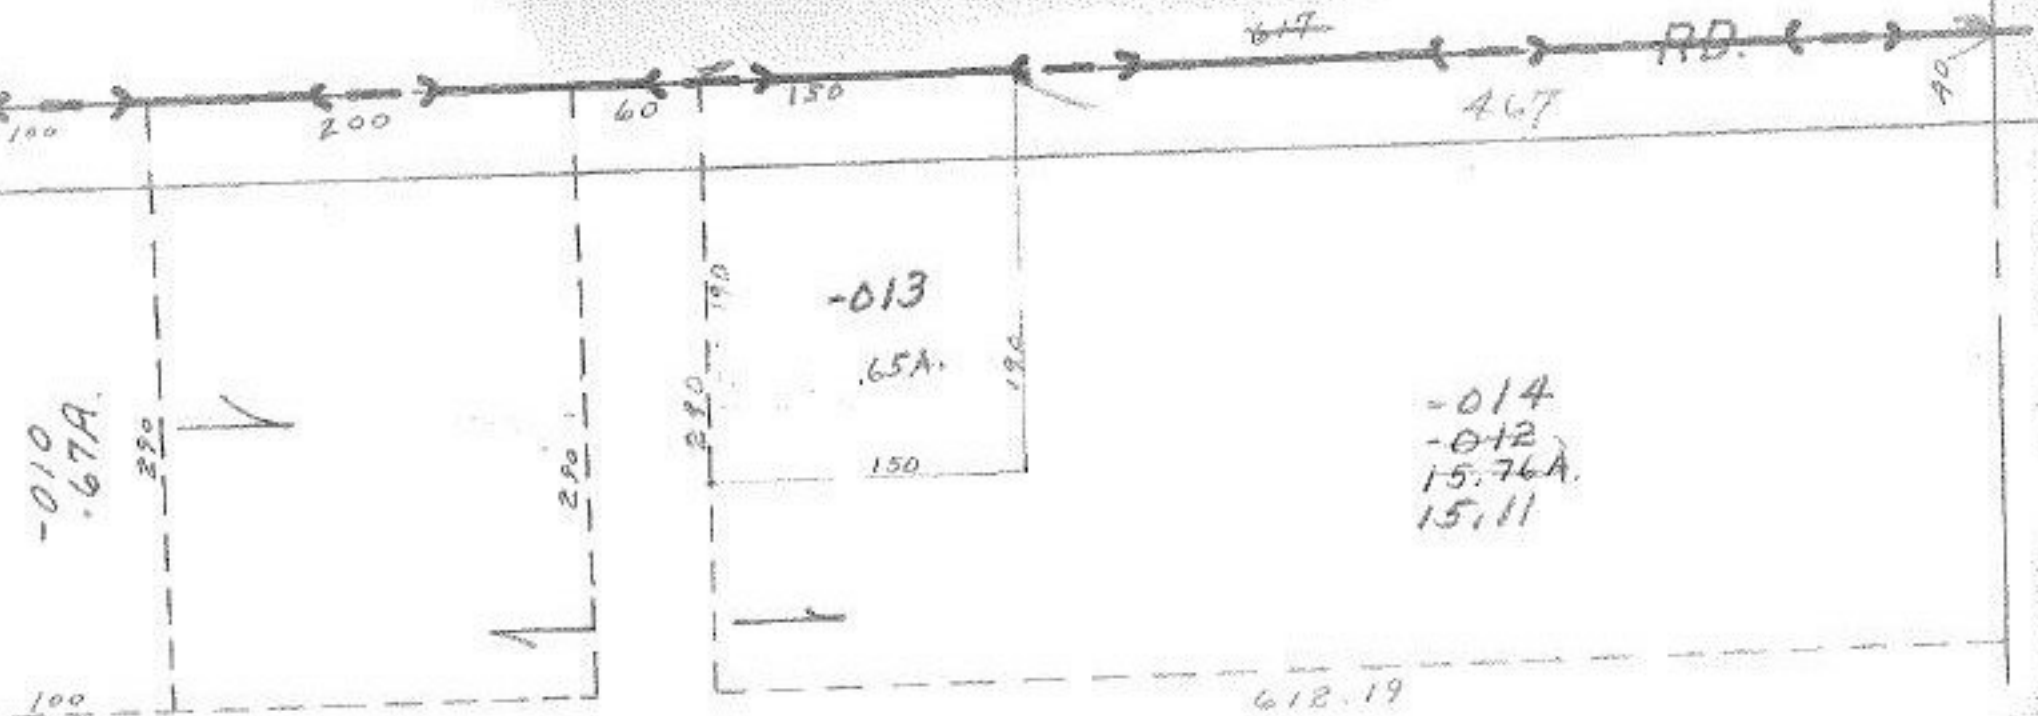

Ohio Tile Corp  
Snyder Co.

RI 4672

7-17-86  
98-61-6

MAY 7 1971

APPROVED  
LORAIN CO.  
MAP DEPT.  
DATE 2/19/71  
5-00-041-B  
BY  
R.J. Kelling

