


4696

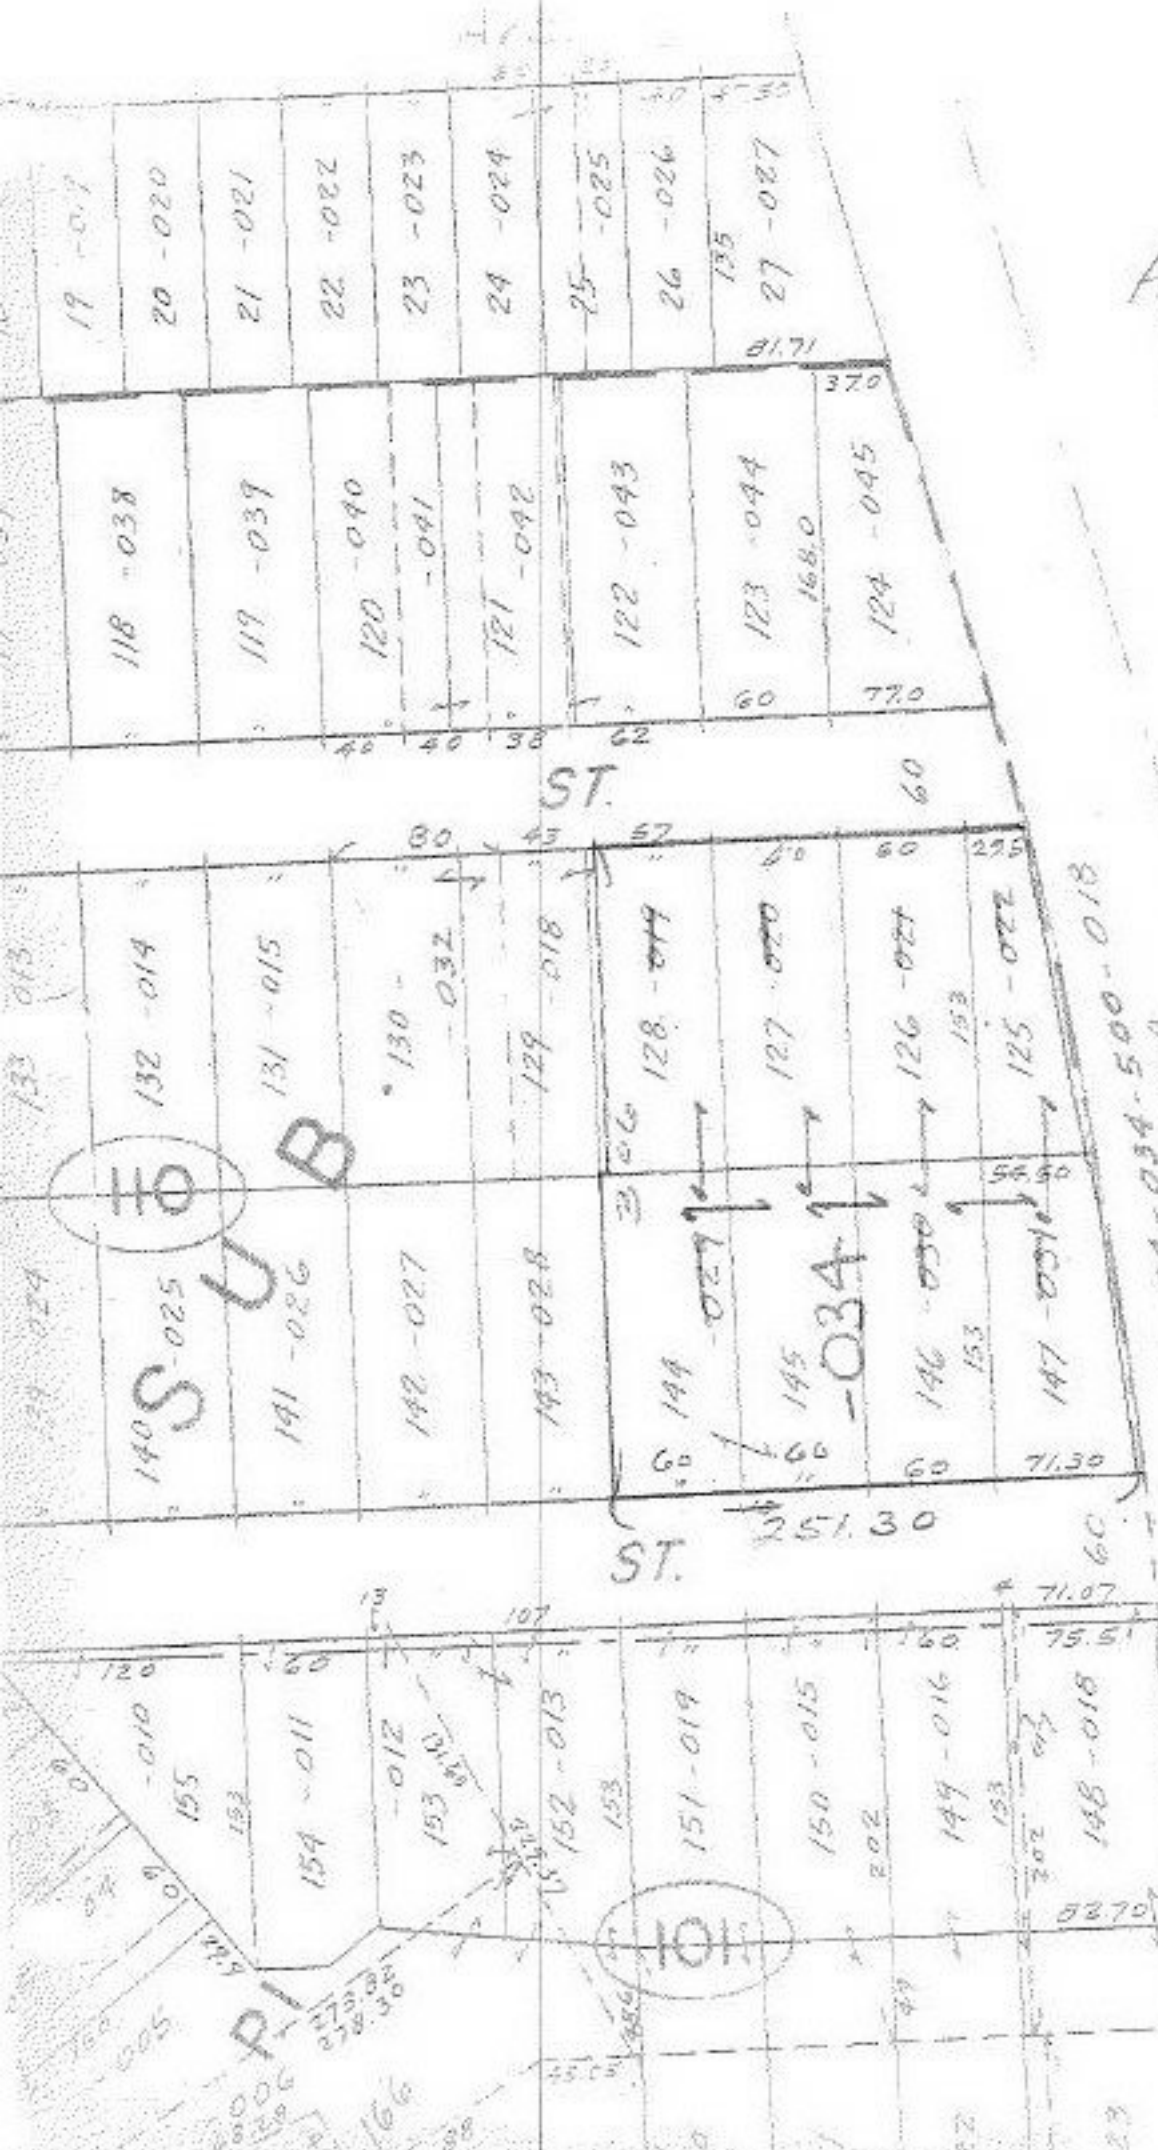

App. Dept
Ella Polndson

JUN 1 8 1900
 4696
 APPROVED
 LORAIN CO.
 MAP DEPT.
 DATE 2-24-71
 6-80
 BY L.W. Hall

153
 153

 306

06-24-034-500-018
 Pt. 11, 68A

680
 70
 SEE 6-81
 251.30

 66
 60
 60
 71.30

WA Gramans V3 P9