


4699

808.67



SEE 11-C

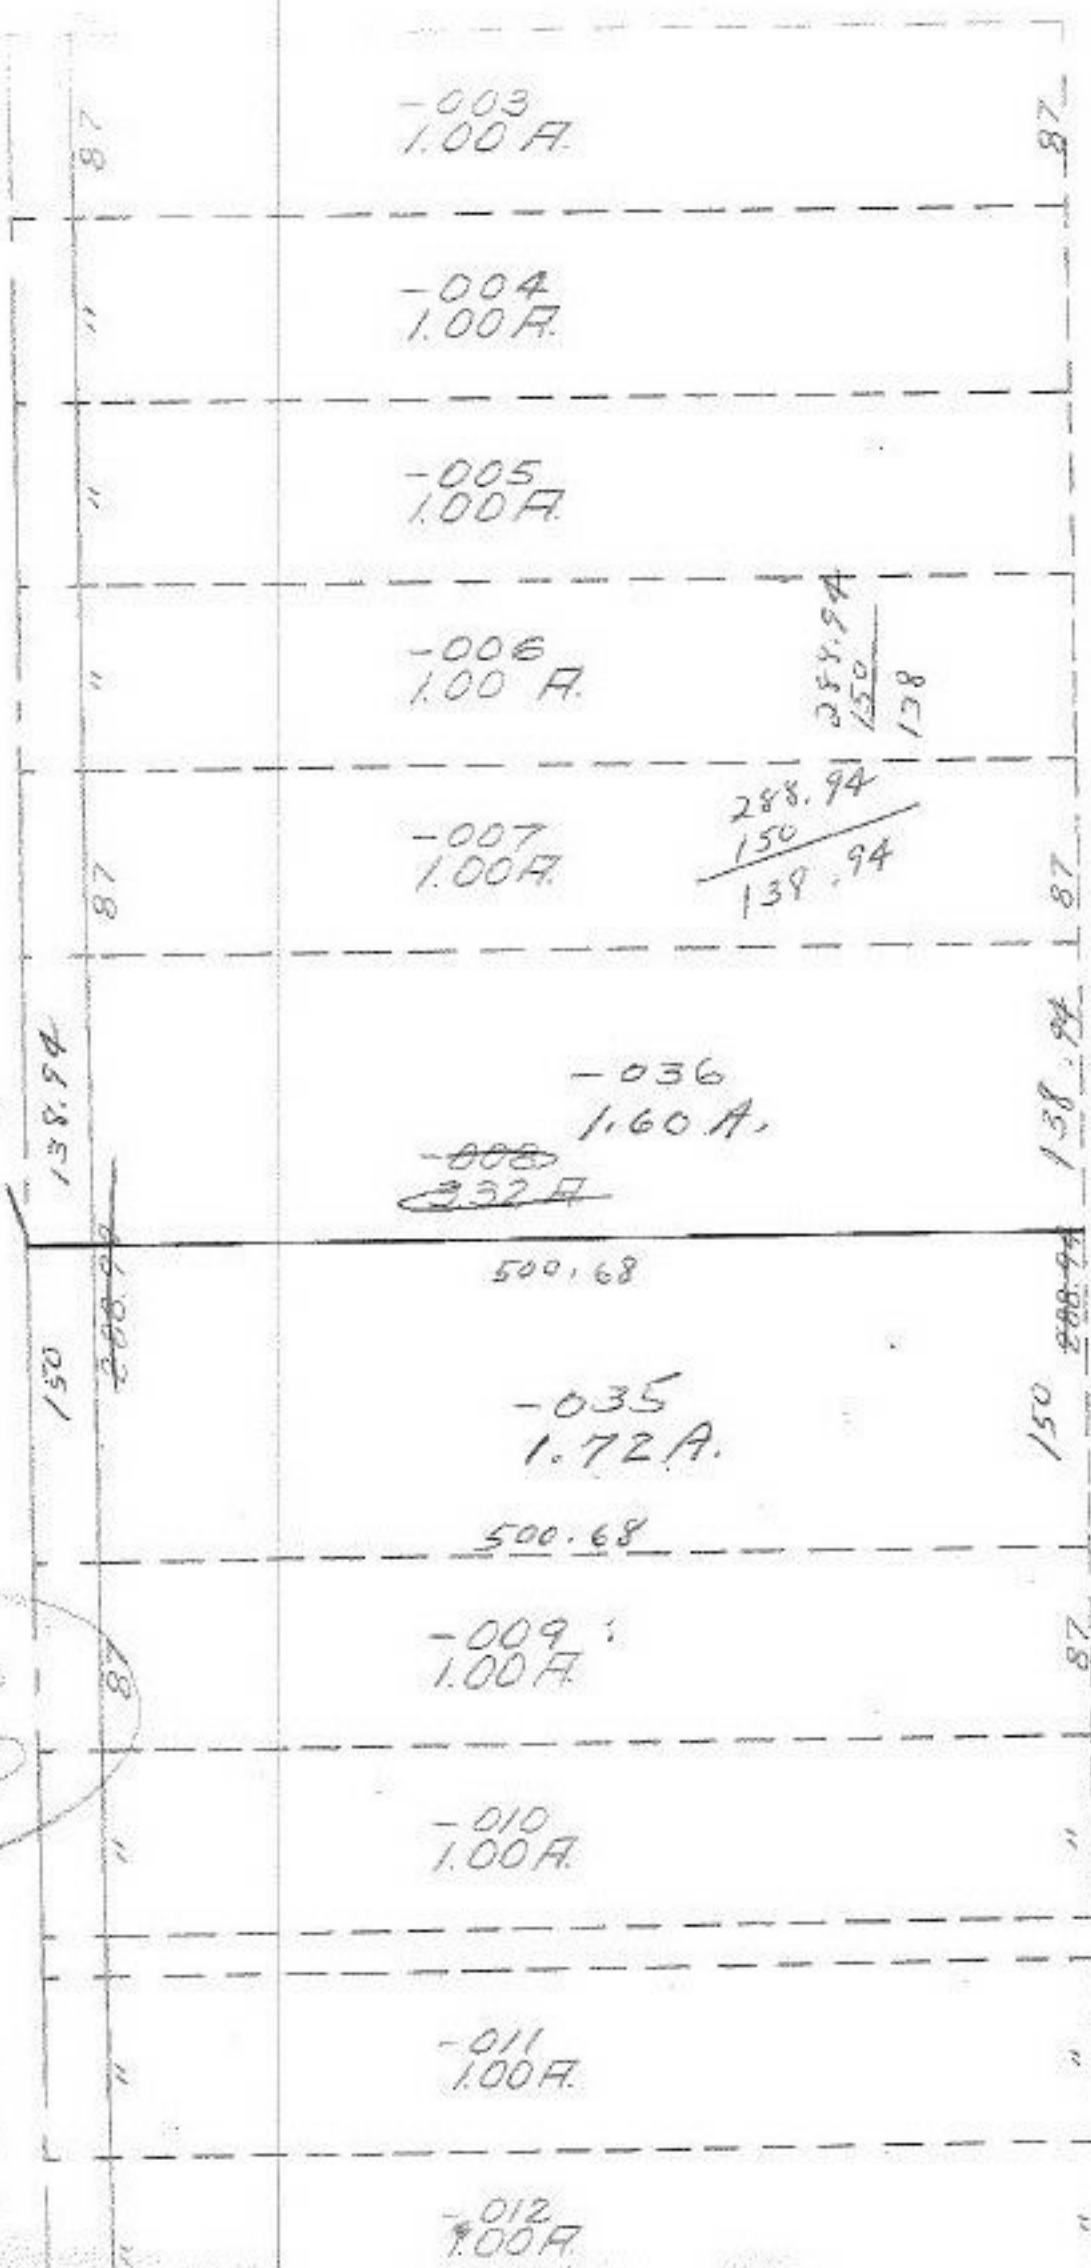

MAR 16 1971

332
172
160

4699

APPROVED
LORAIN CO.
MAP DEPT.
DATE 2-26-71
11-00-026-A
BY *[Signature]*

D.S.
2-24-71