


4700

511

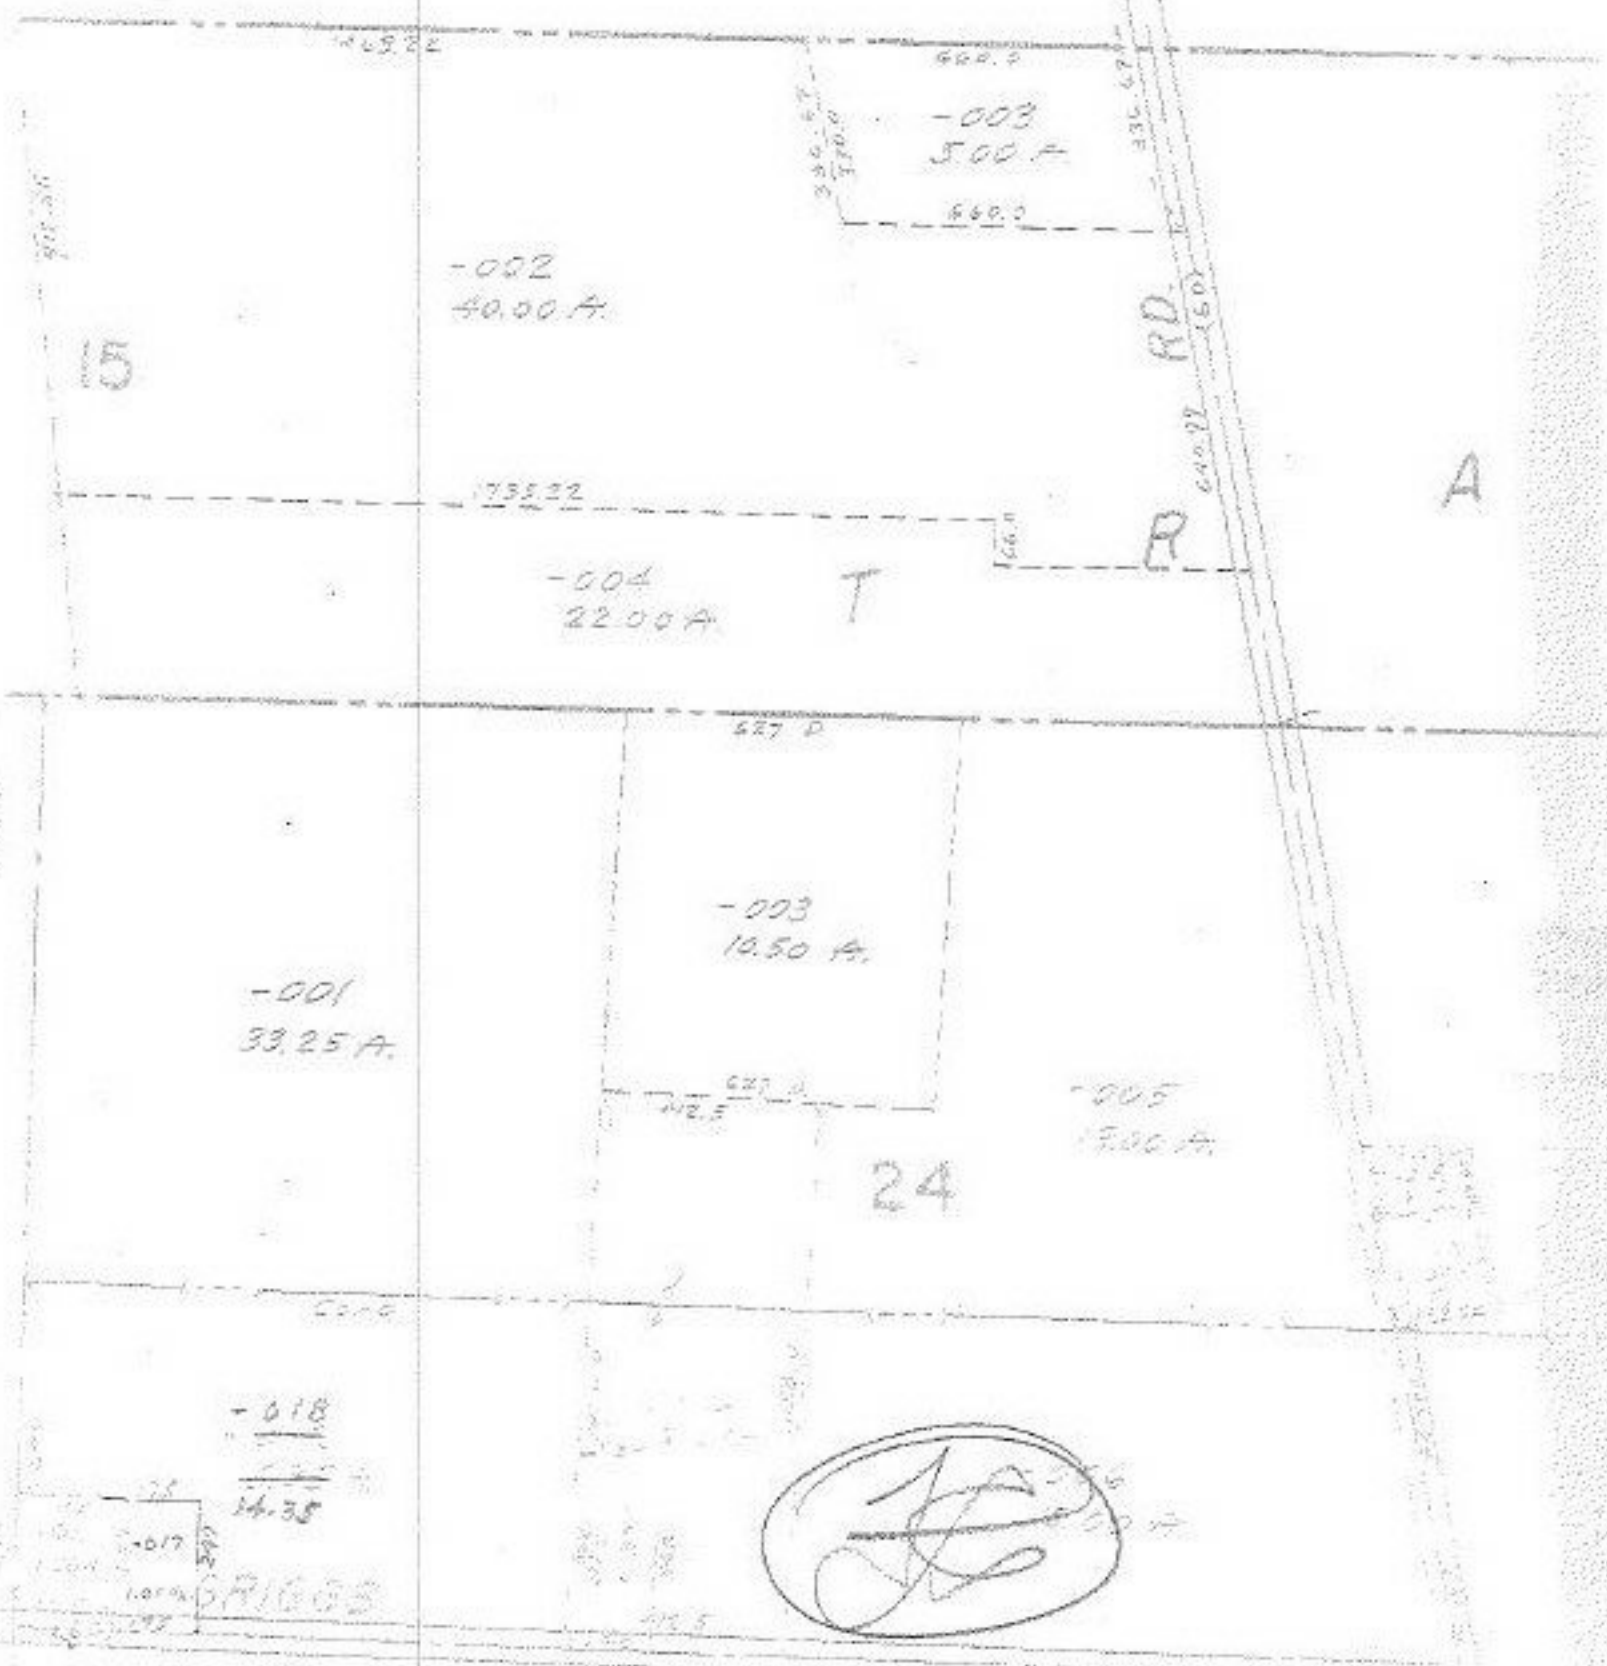

APPROVED
 LORAIN CO.
 MAP DEPT.
 DATE 3/17/71
 20-C
 BY R.J. Kelling

1. 4700
 2. 3180
 Elevation of Str. Trans.
 #4 2-12-71
 D.V. 1018-553

APR 16 1971