

LAKE RD. 60


CLEVELAND

SAILORSKY

SEE 1-C  
LIBERTY AVE. 6

#4713

47

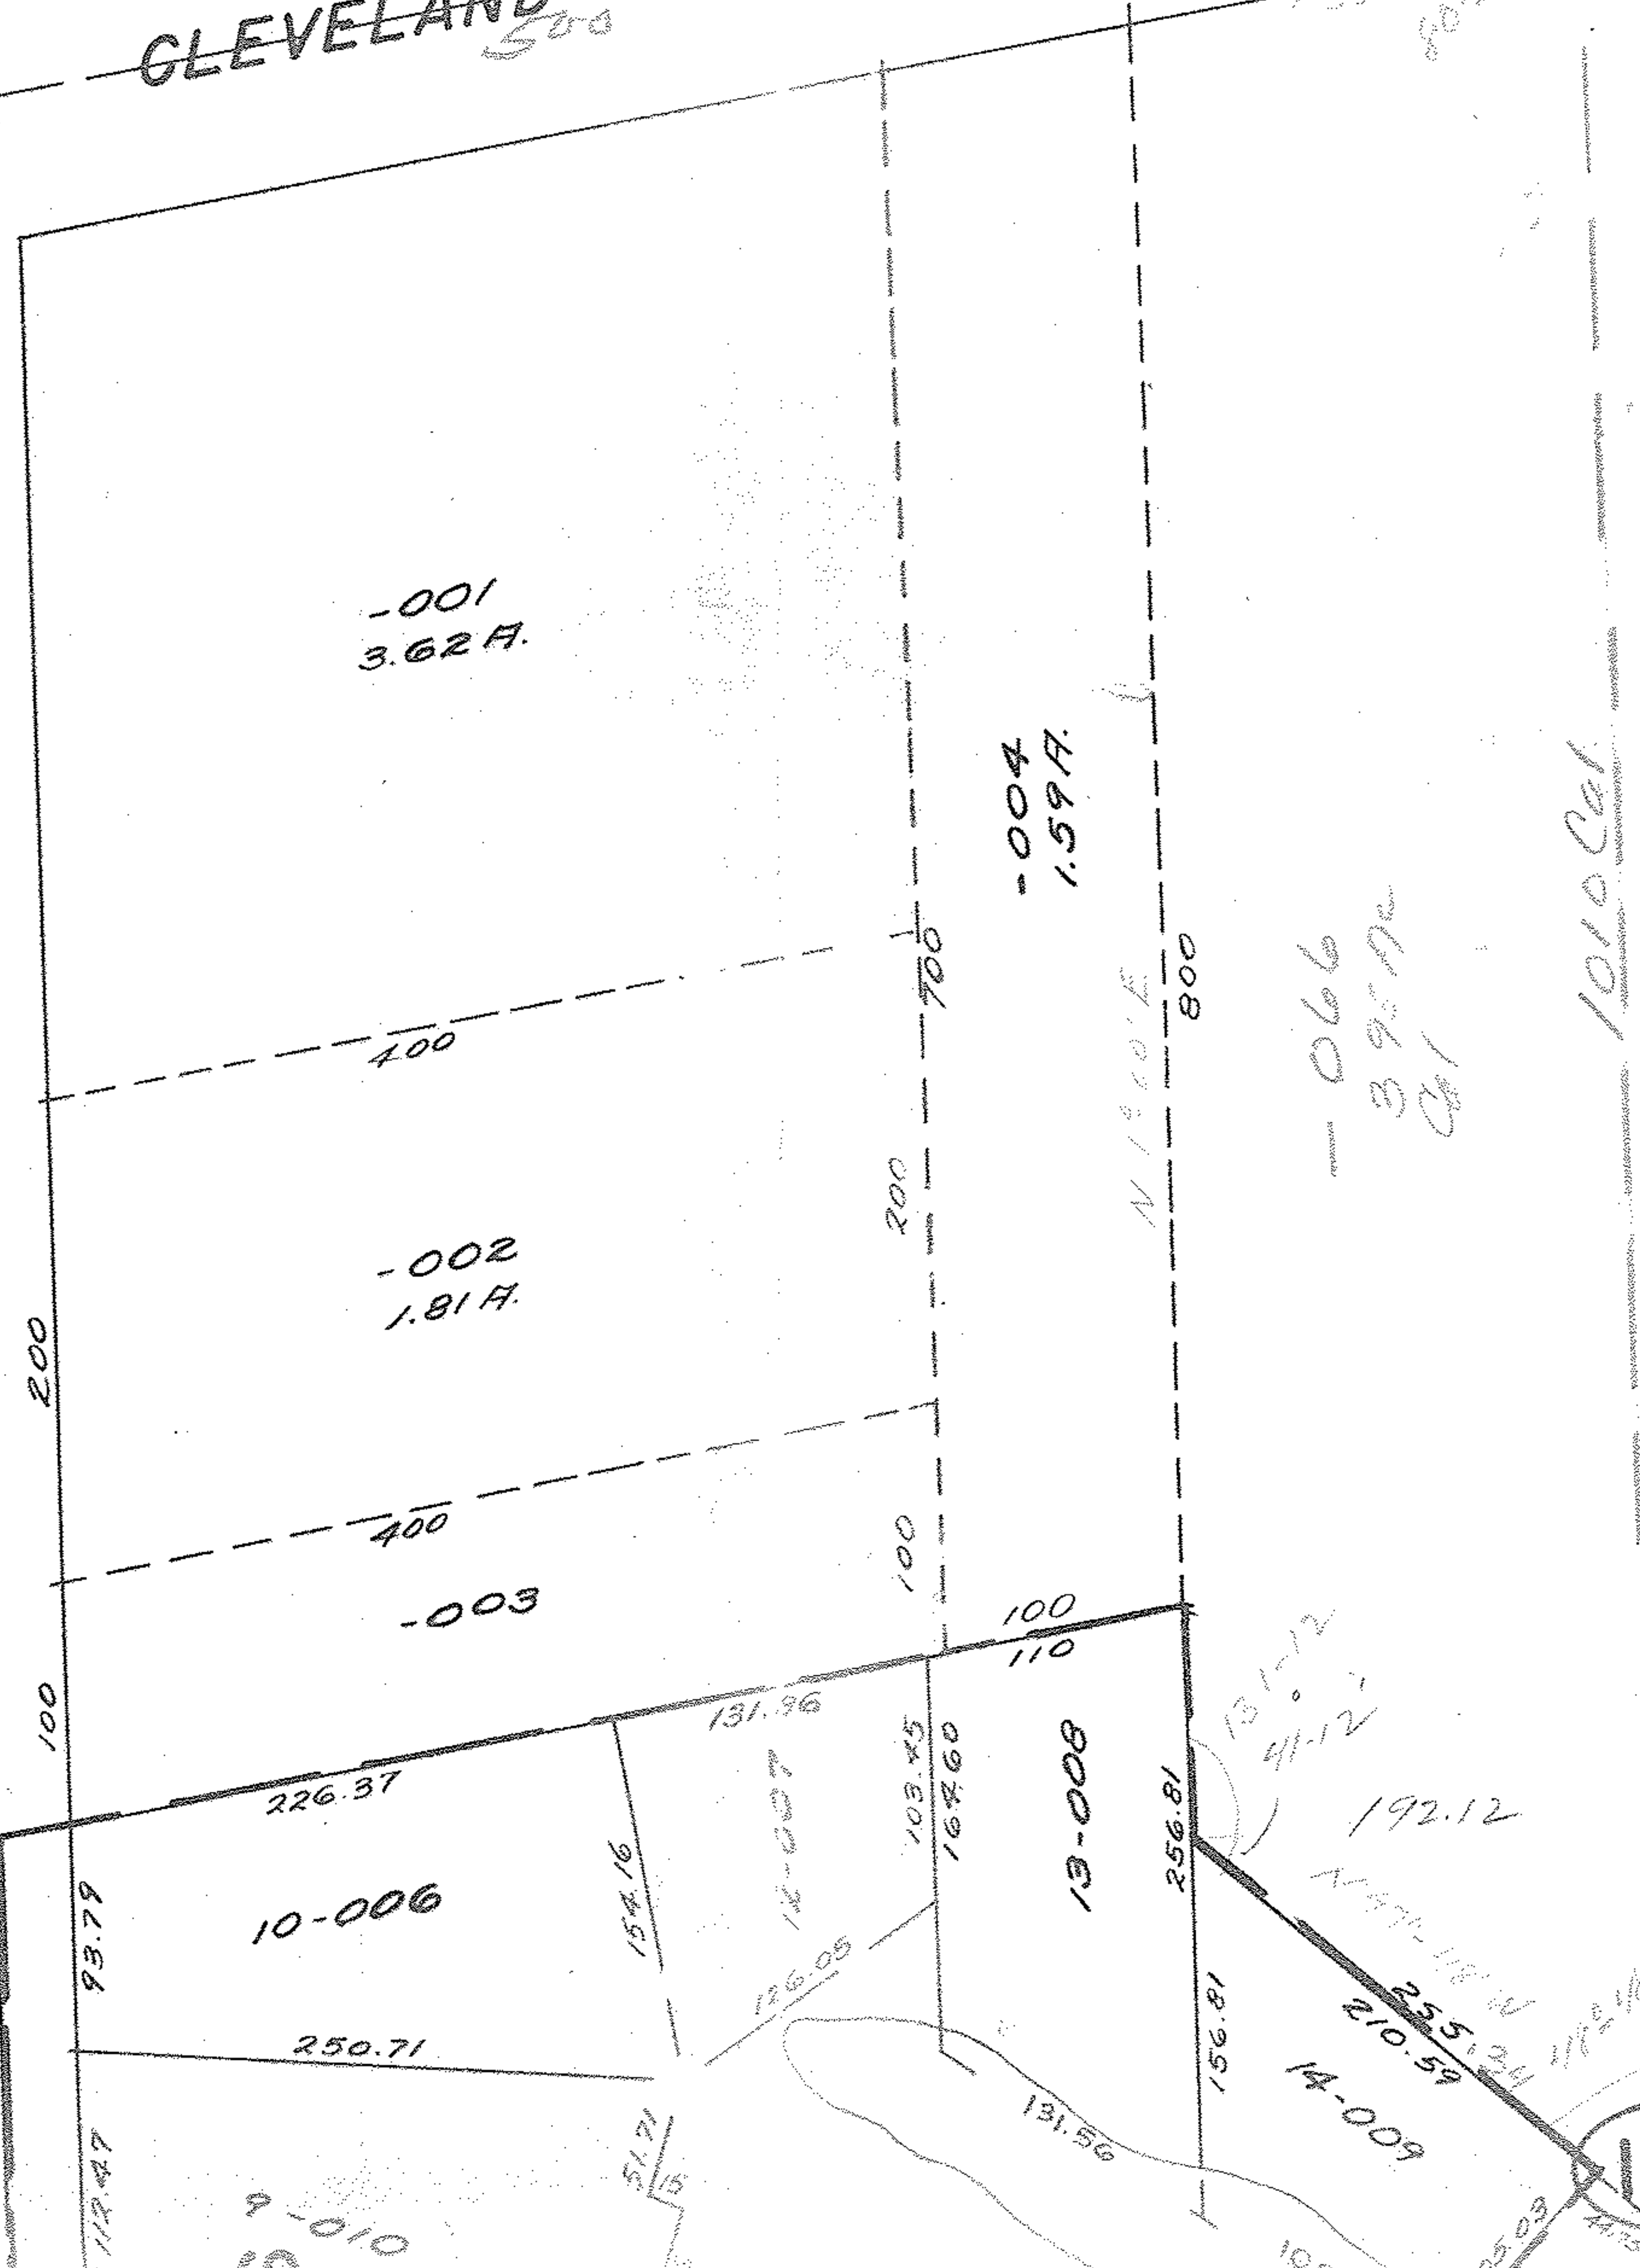

AVN  $191.25 \times 800 = 153,000.00$

$4 \frac{15}{36} \times 19136 = 2870.40$

$4 \frac{85}{170} \times 192.12 = 16,330.00$

---

$172,200.60$

$43560$

$= 31.9$

97-27.30

131-12-00

48-48-00

80-32.30

---

358 119-60

358-120

360 2

067

-005

13.57A.

9.67AC

MAR 16 1971

APPROVED

LORAIN CO.

MAP DEPT.

DATE 3-2-71

1-00-005-C

BY L W Hall

170

300

300

800

1000

7-17-86

S.S.

104

SEE 1-C