



Transfer Sheet
Filed Away

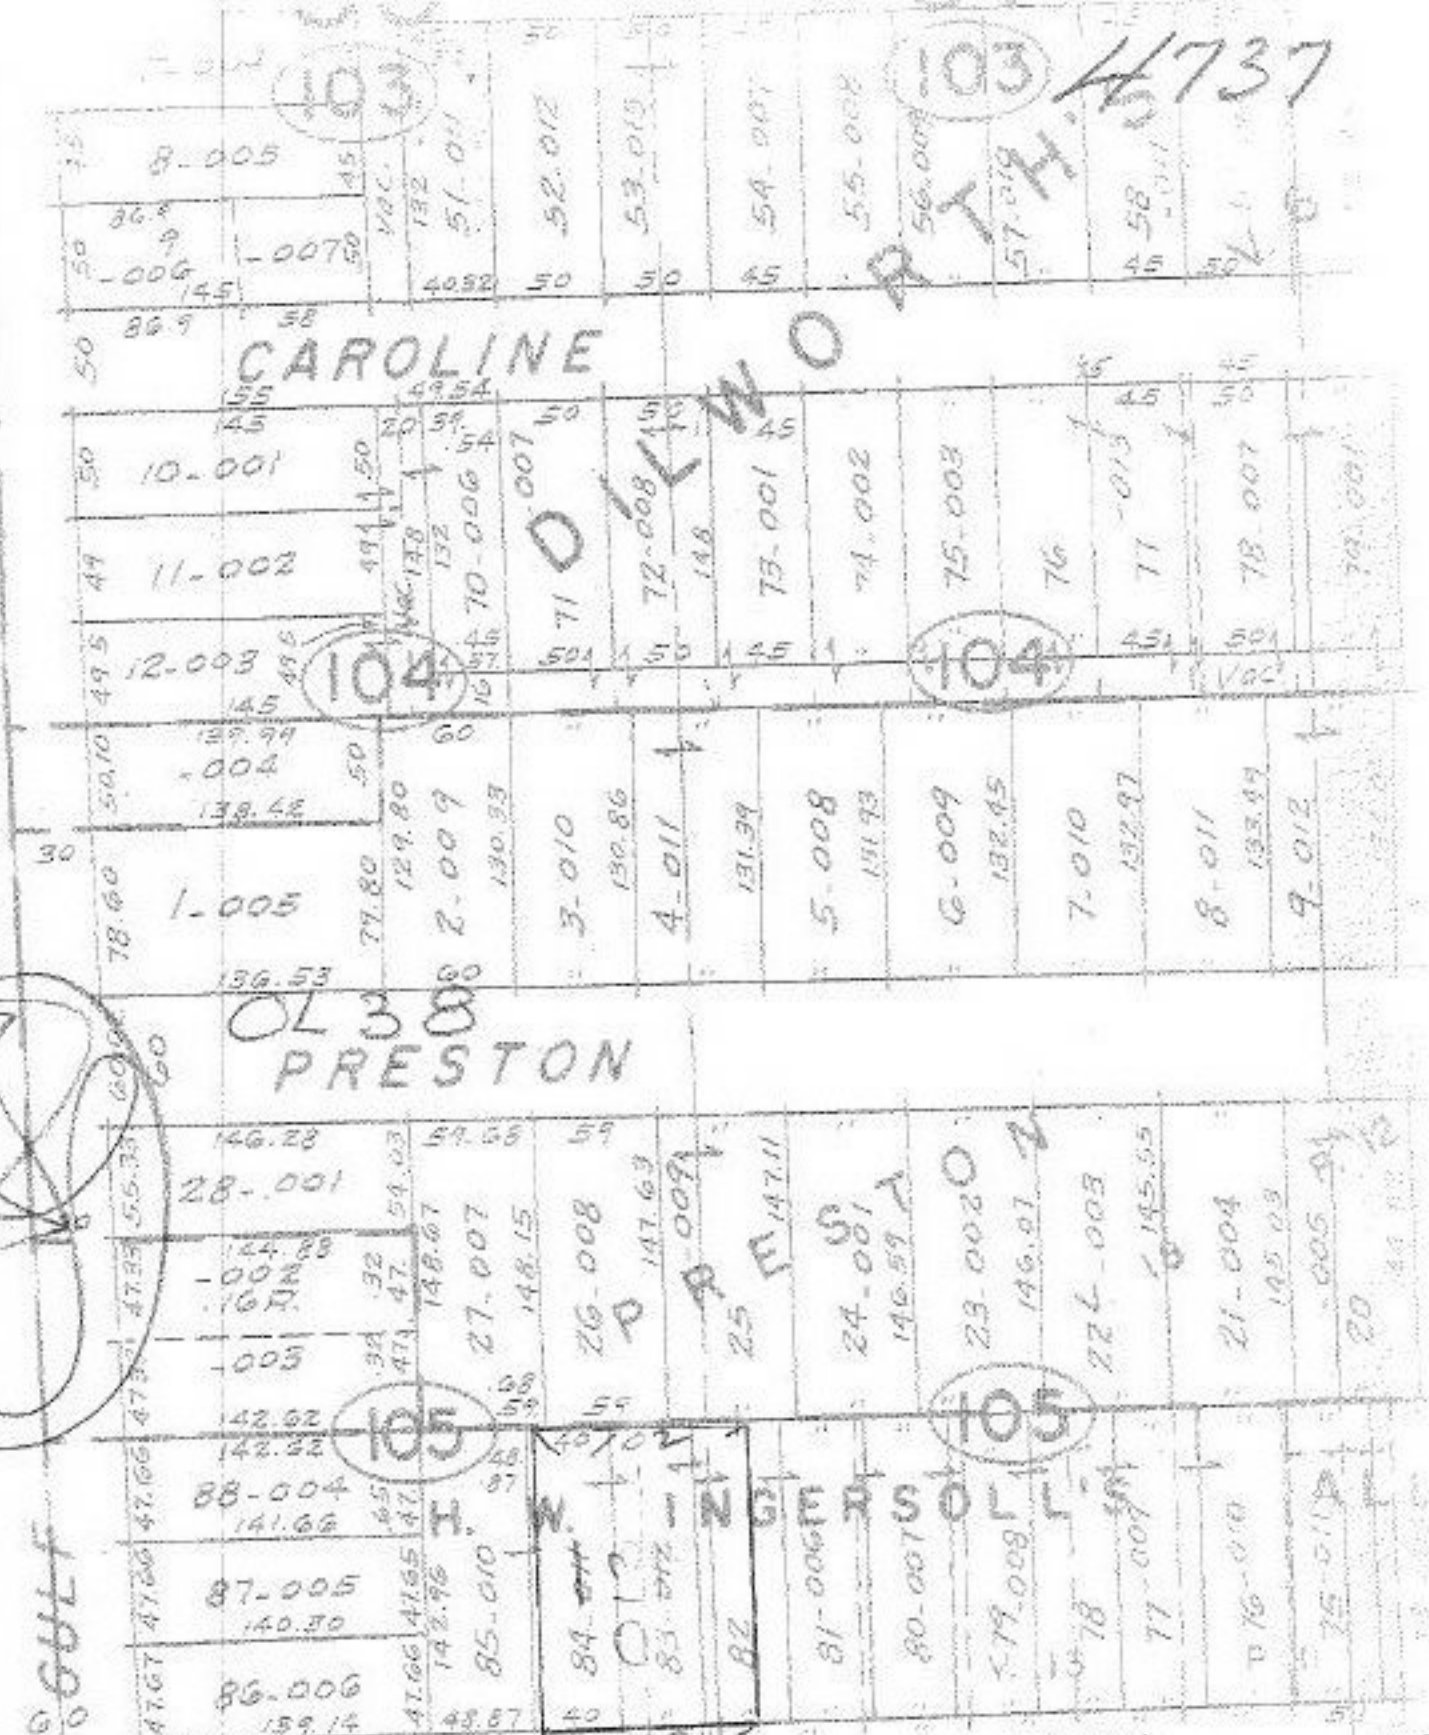

1737

APR 18 1971

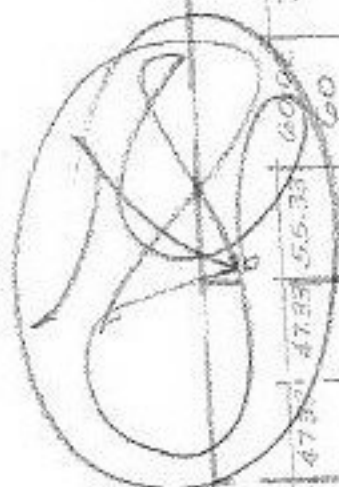

Proch...
Daniel...
Kurovitch

GOLF

06-25-038-105-013

Note CL No. APR 18 1971

ELYRIA

SCALE: 1" = 100'

1737
 APPROVED
 LORAIN CO.
 MAP DEPT.
 DATE 3-10-71
 6-86
 BY [Signature]
 6-86