

4747

(VERMILLION RD.)

42°  
-002  
300 FT.  
311.11

APR 6 1978

4356  
-001  
300 FT.  
300  
4356

-001  
78.98 A.


-002  
42.00 A.

-004  
49.77 A.  
By Cal.  $2942 \times 737$

-004  
50.00 A.

-003  
13.31 A.

PA. 20-05-009-000  
-006  
PA. 11.00 A.  
707.88

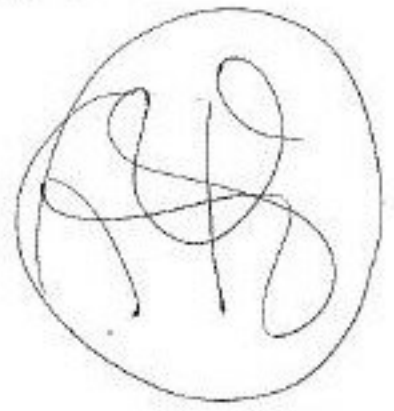

Line 3402.30

1750

15

RD.

1750

171.0

171.0

Map Correction

14

707.94

# 4747  
Map Page 20-C