

Pl. 03-00-033-B  
Pl. 8-24-A

109


4762

JUN 10 1971

002  
2.73 A.



APPROVED  
LORAIN CO.  
MAP DEPT.  
DATE 3-22-71  
3-00-033A  
BY [Signature]

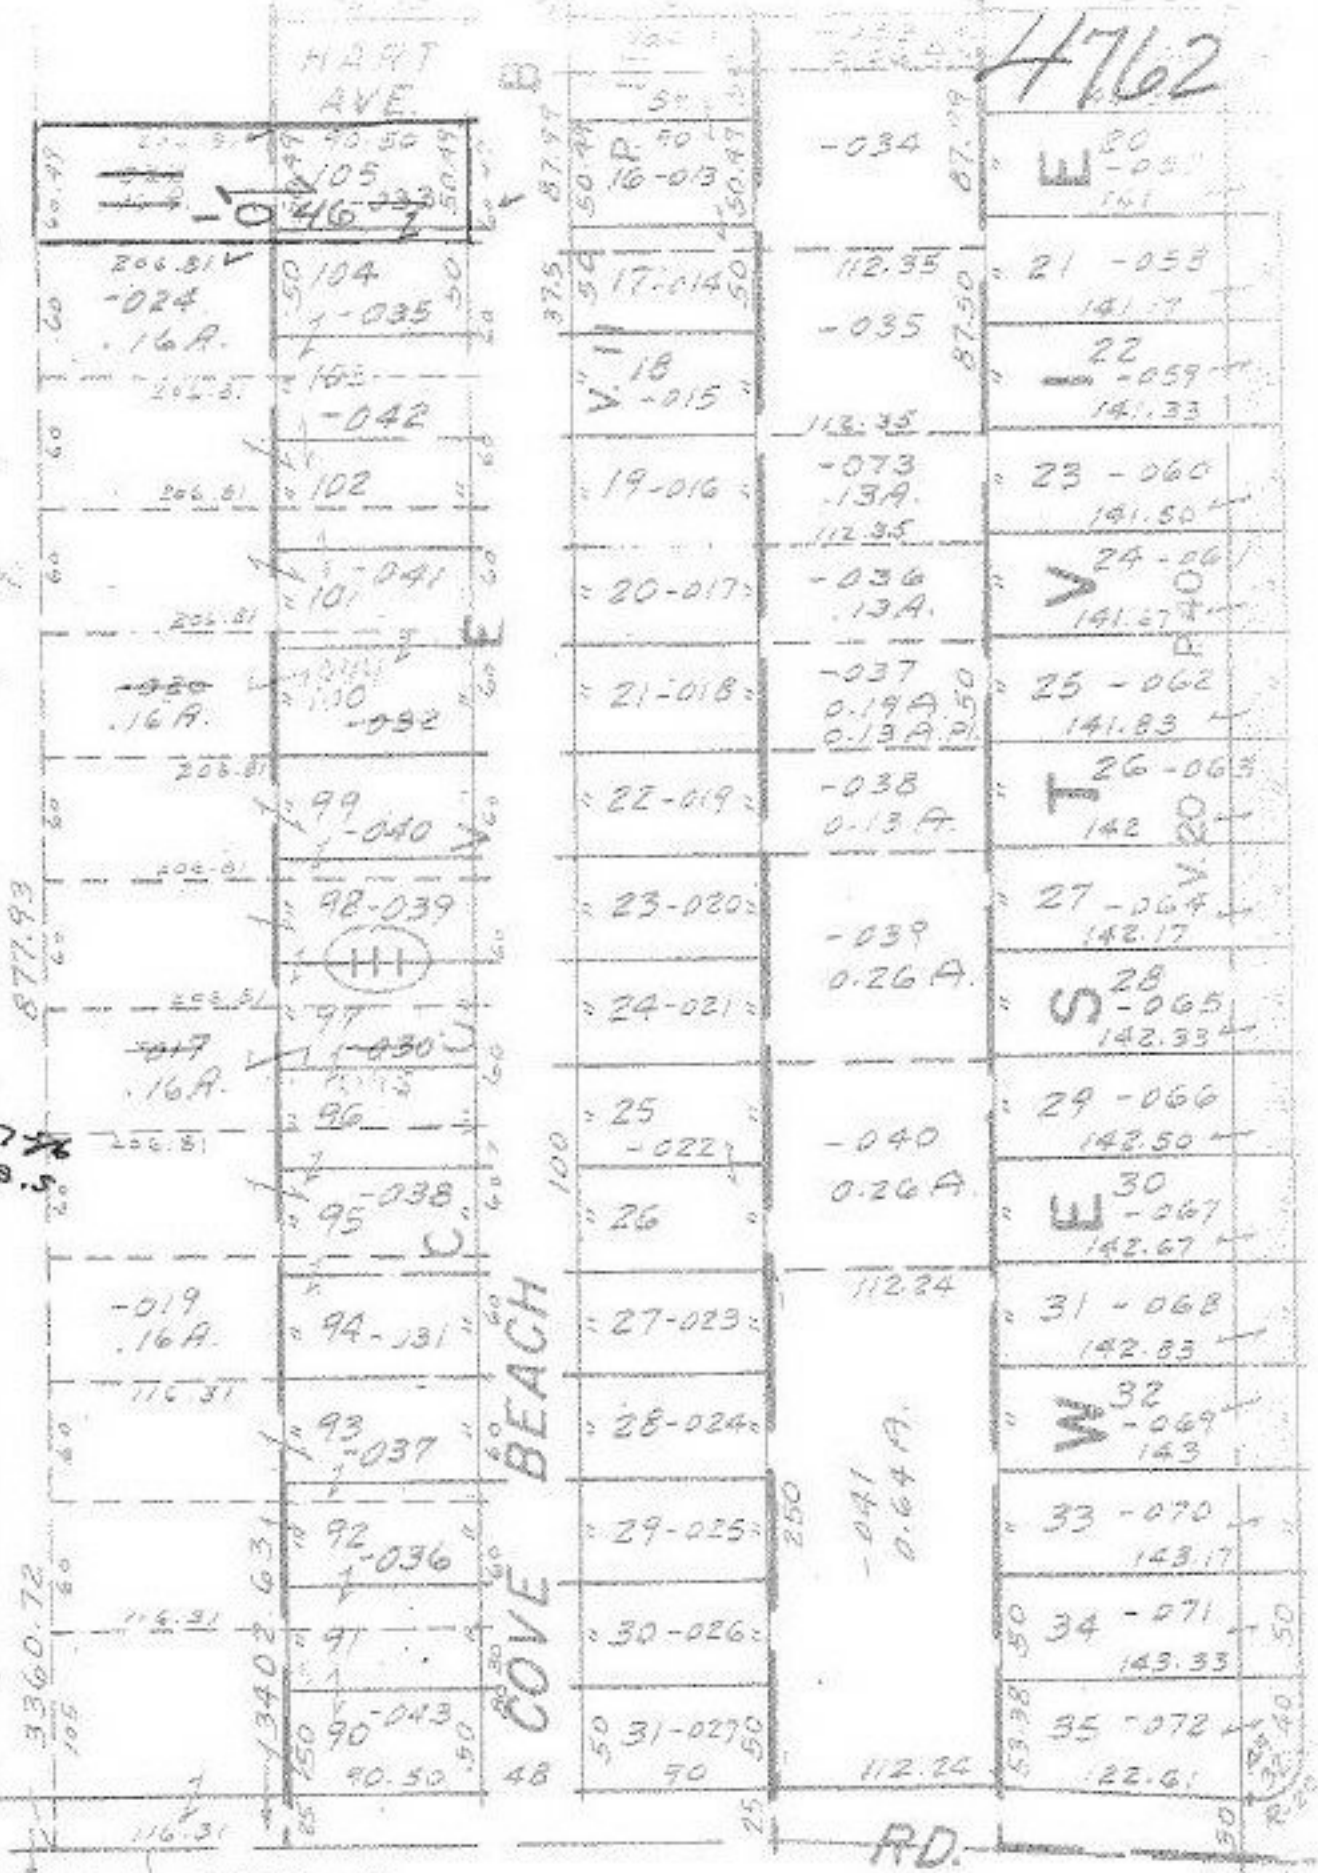

SEE 3-00-033-B  
Note P.P. No 15  
03-00-033-111-046

Block No

Yellow Trans sheet + File  
# 64-2971

3-00-033A