



4783

SEE 6-60

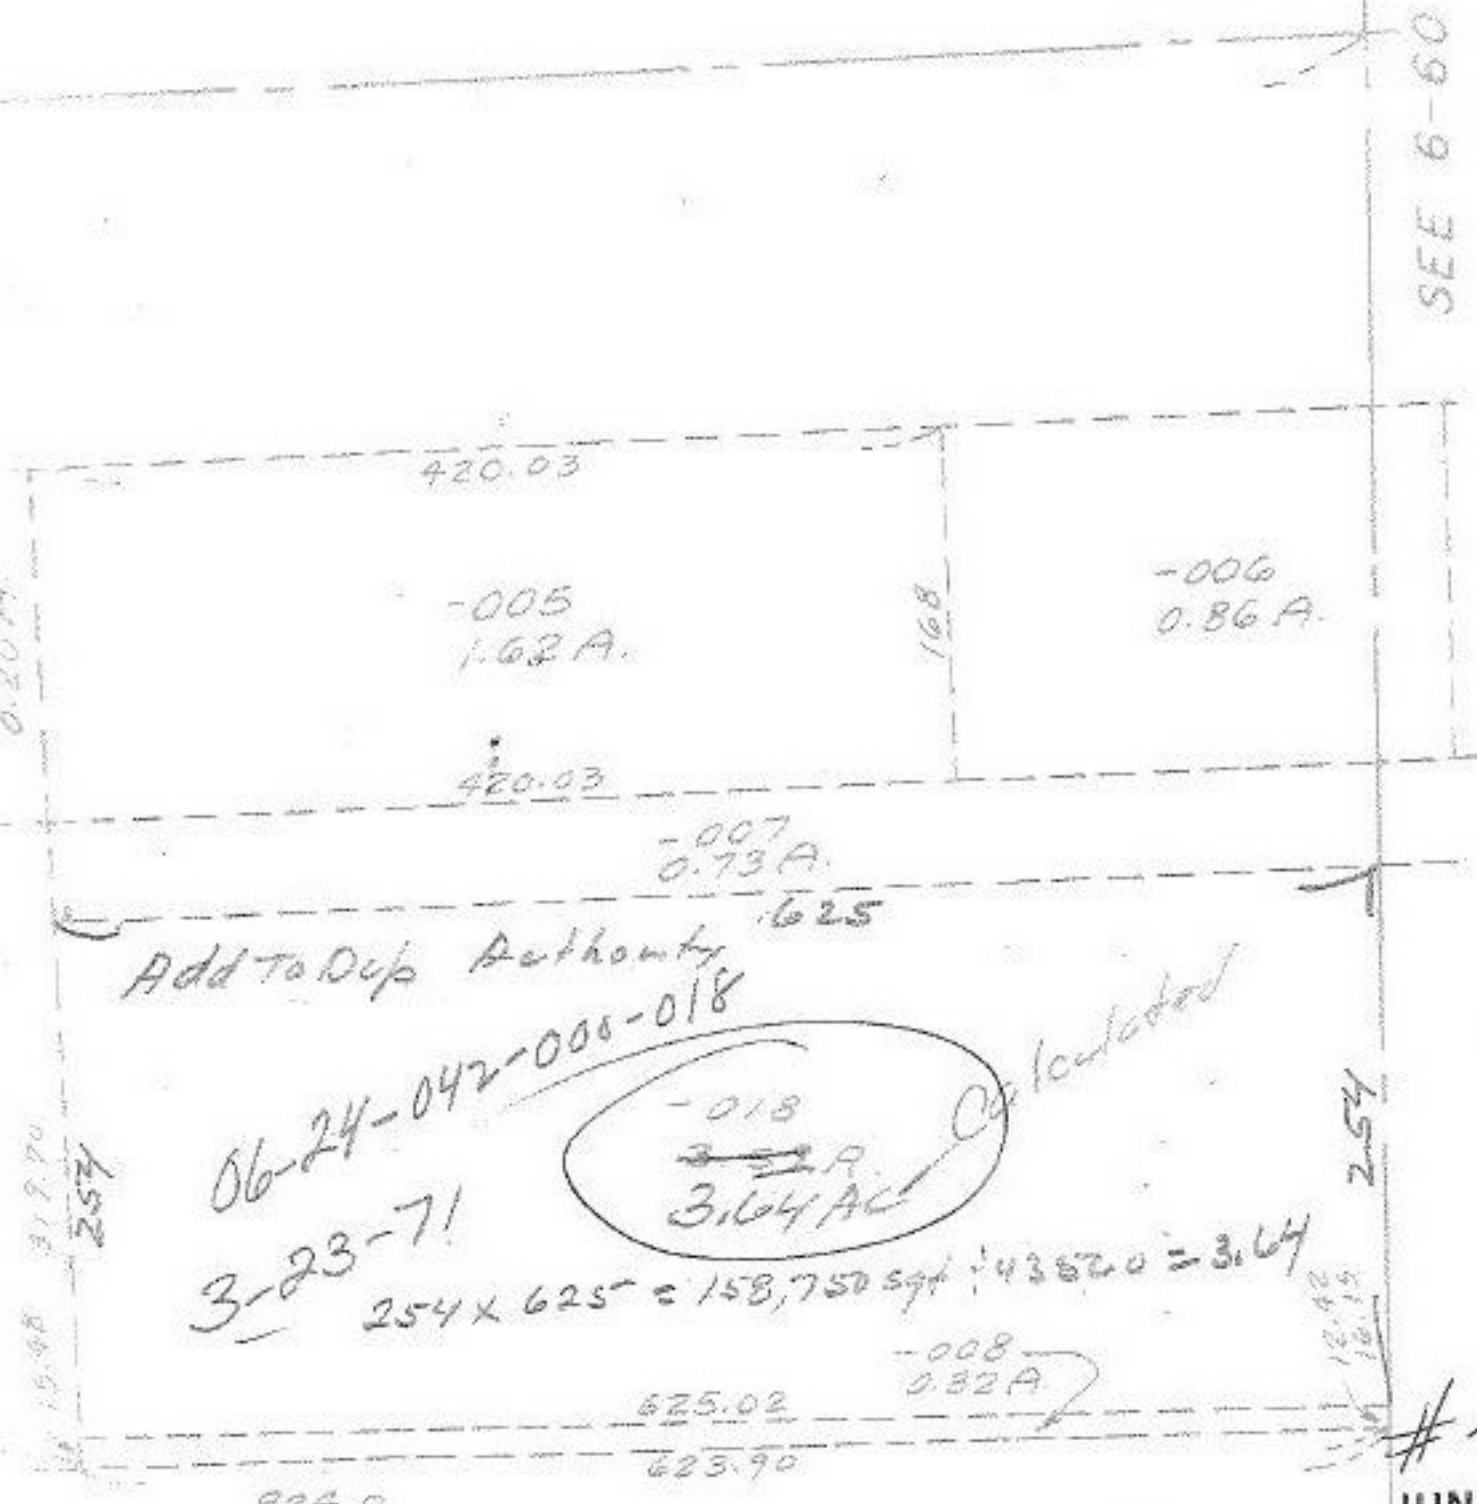

Add to Dep Authority 625

06-24-042-000-018
3-23-71

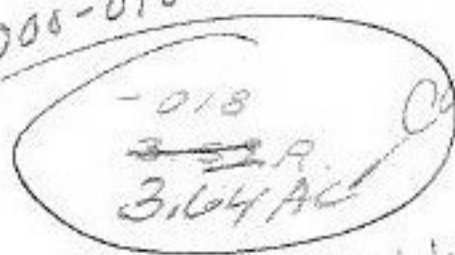


$254 \times 625 = 158,750 \text{ sqft} \div 43820 = 3.64$

4783

JUN 25 1970

4783
 APPROVED
 LORAIN CO.
 MAP DEPT.
 DATE 3-23-71
 6-59
 BY LWHall

014
0.19 A.

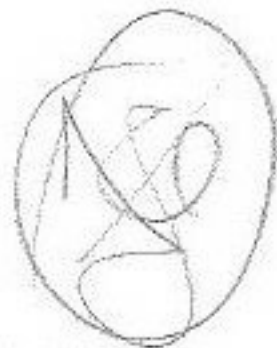

6-59

APPROVED
 LORAIN CO.
 MAP DEPT.
 DATE 3-23-71
 6-59
 BY [Signature]