


4792

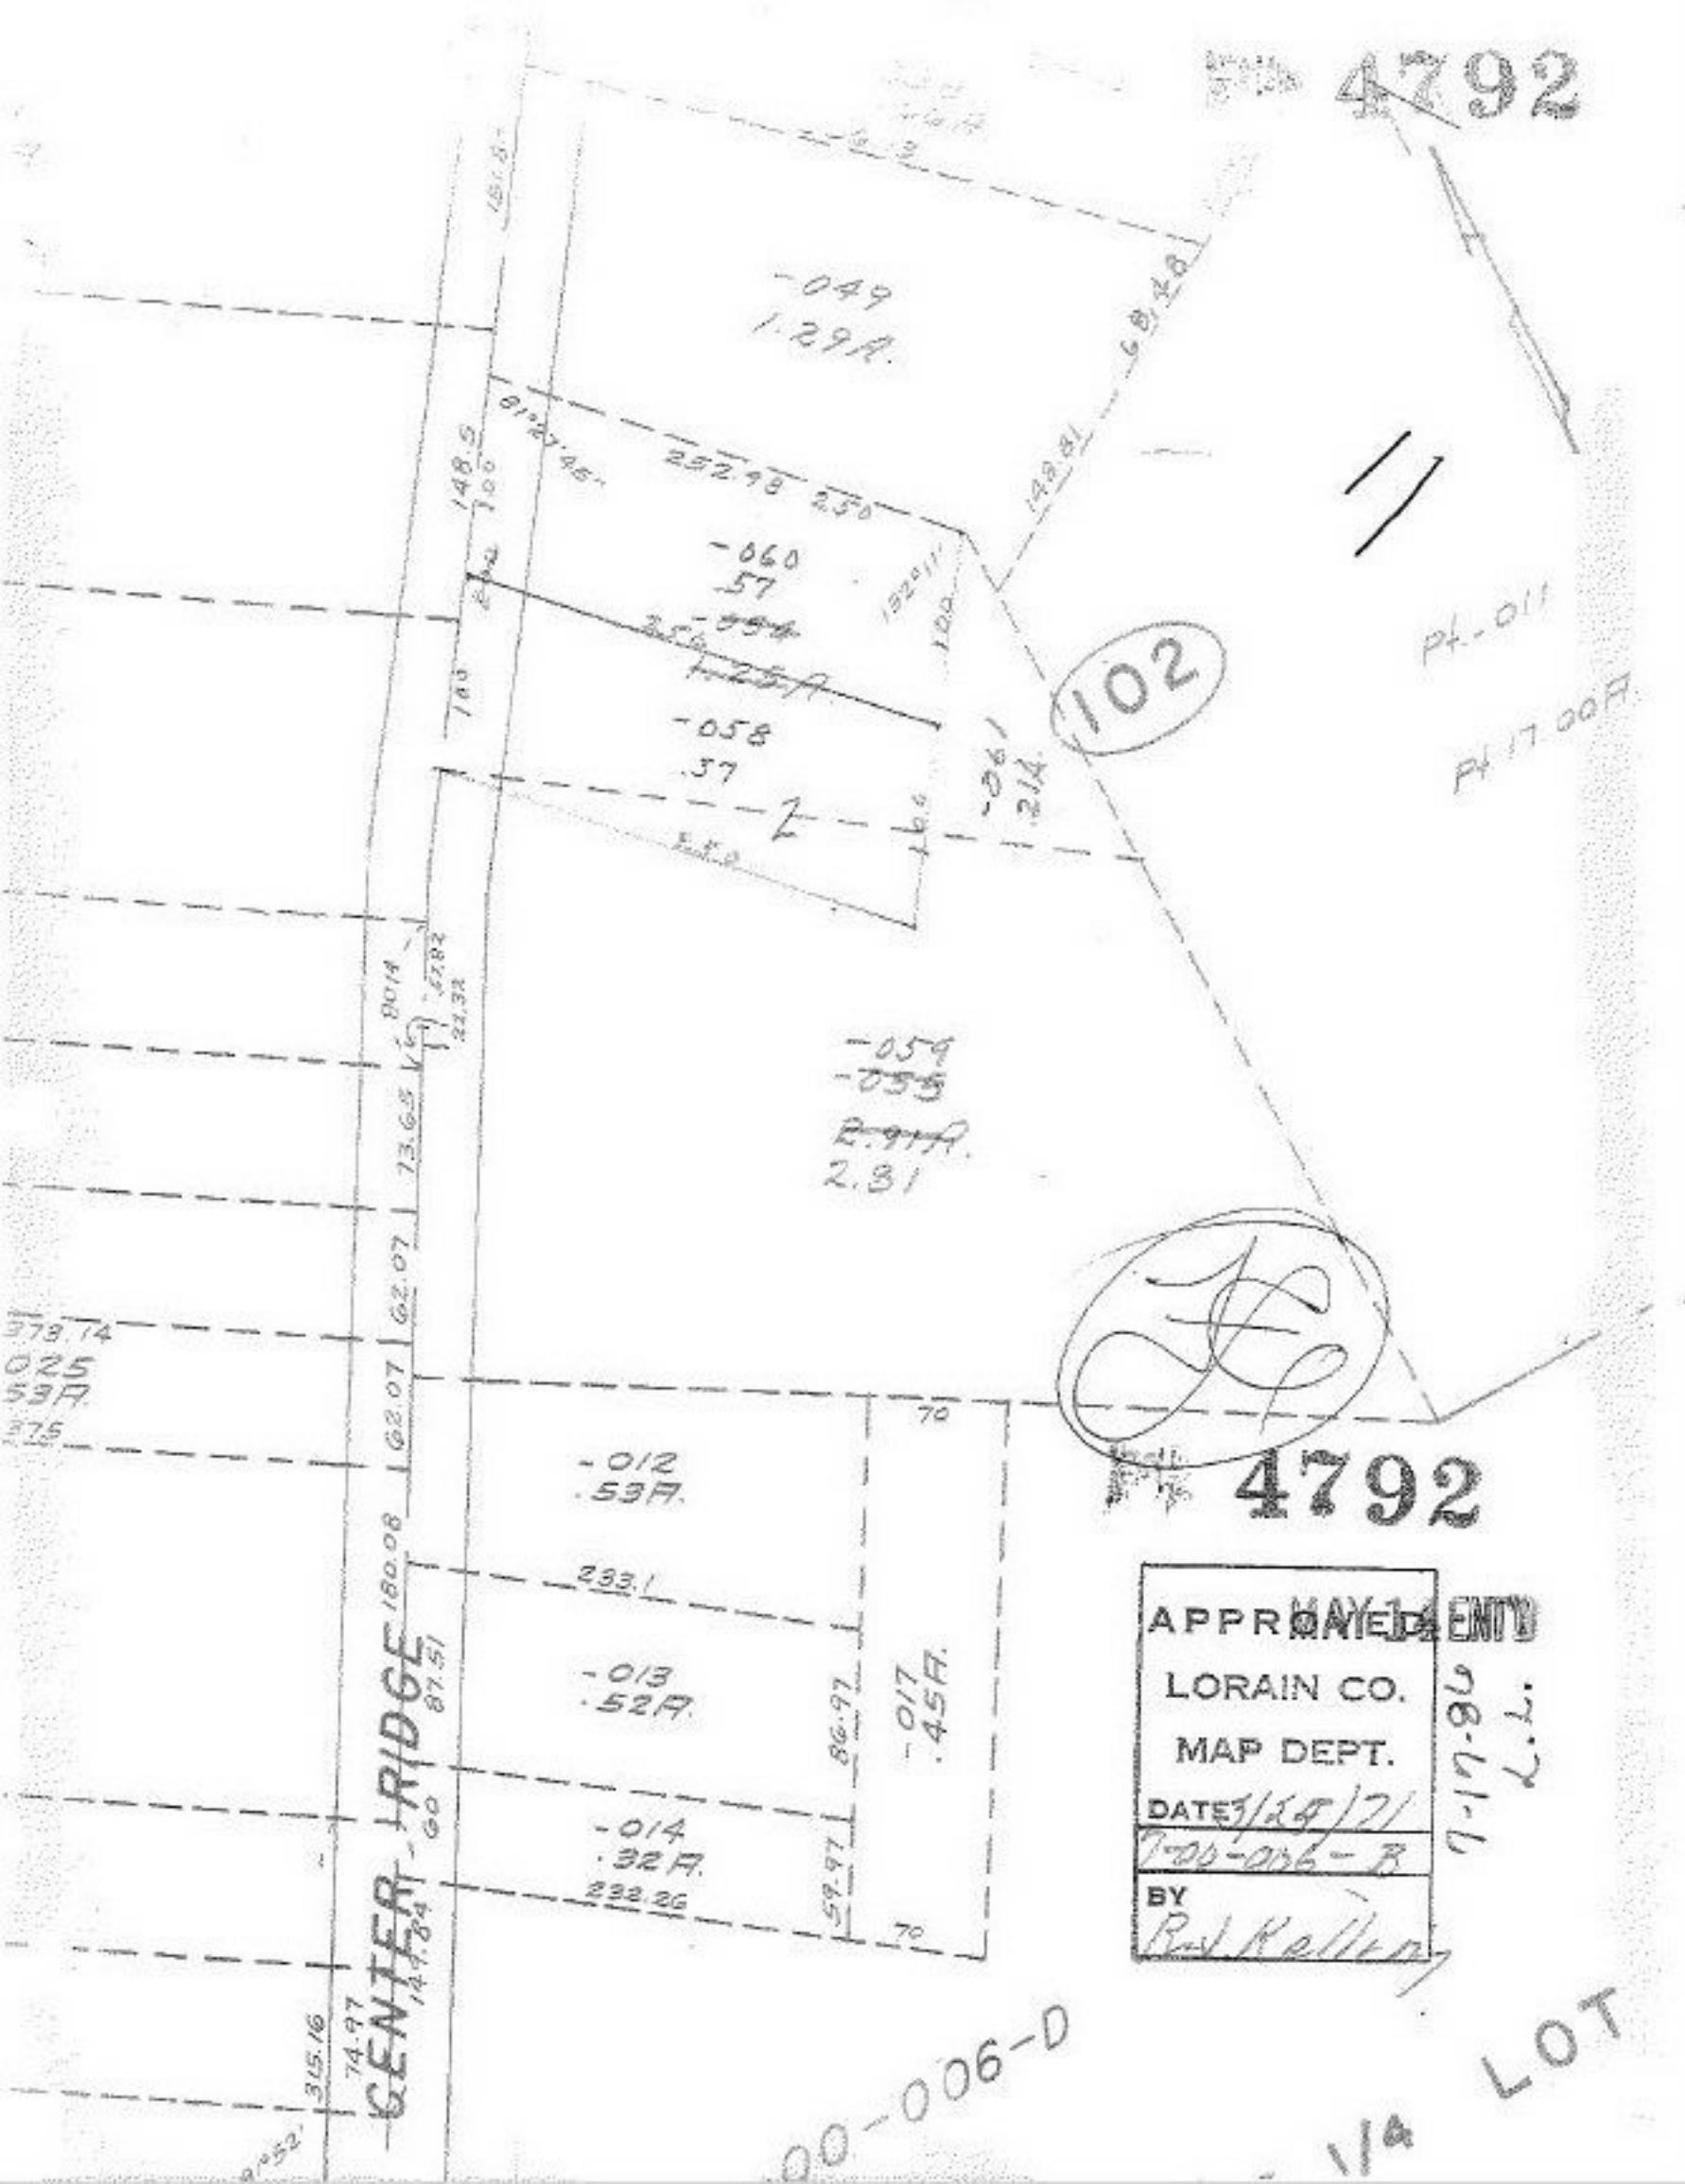

102

LH

4792

APPROVED BY  
 LORAIN CO.  
 MAP DEPT.  
 DATE 3/25/71  
 7-00-006-B  
 BY  
 Bud Keller

9-17-86  
L.L.

00-006-D

1/4 LOT

GENTLE BRIDGE