

CLEVELAND SANDUSKY



(LAKE)

(LIBERTY AVE.)

1084
4801

500

Pt. 001 Dupl
Pt. 756 A R. R.
Pt. 7.27 A Dup #2
Pt. 14.63 A Total

N. Y. C. &

ST. L.

Pt. 01-00-001-110-010

Pt 23.02 A.

862.50

129.90 117.52

87.67 64.77

91.98
-004
.24A
112.74

333.13
-005

-006
.07A

16.50


15.22

~~5005~~
10.009

~~40450~~ 558.16
578.46
558.46

115

0.01
33.48 A.
Per Survey Hollis

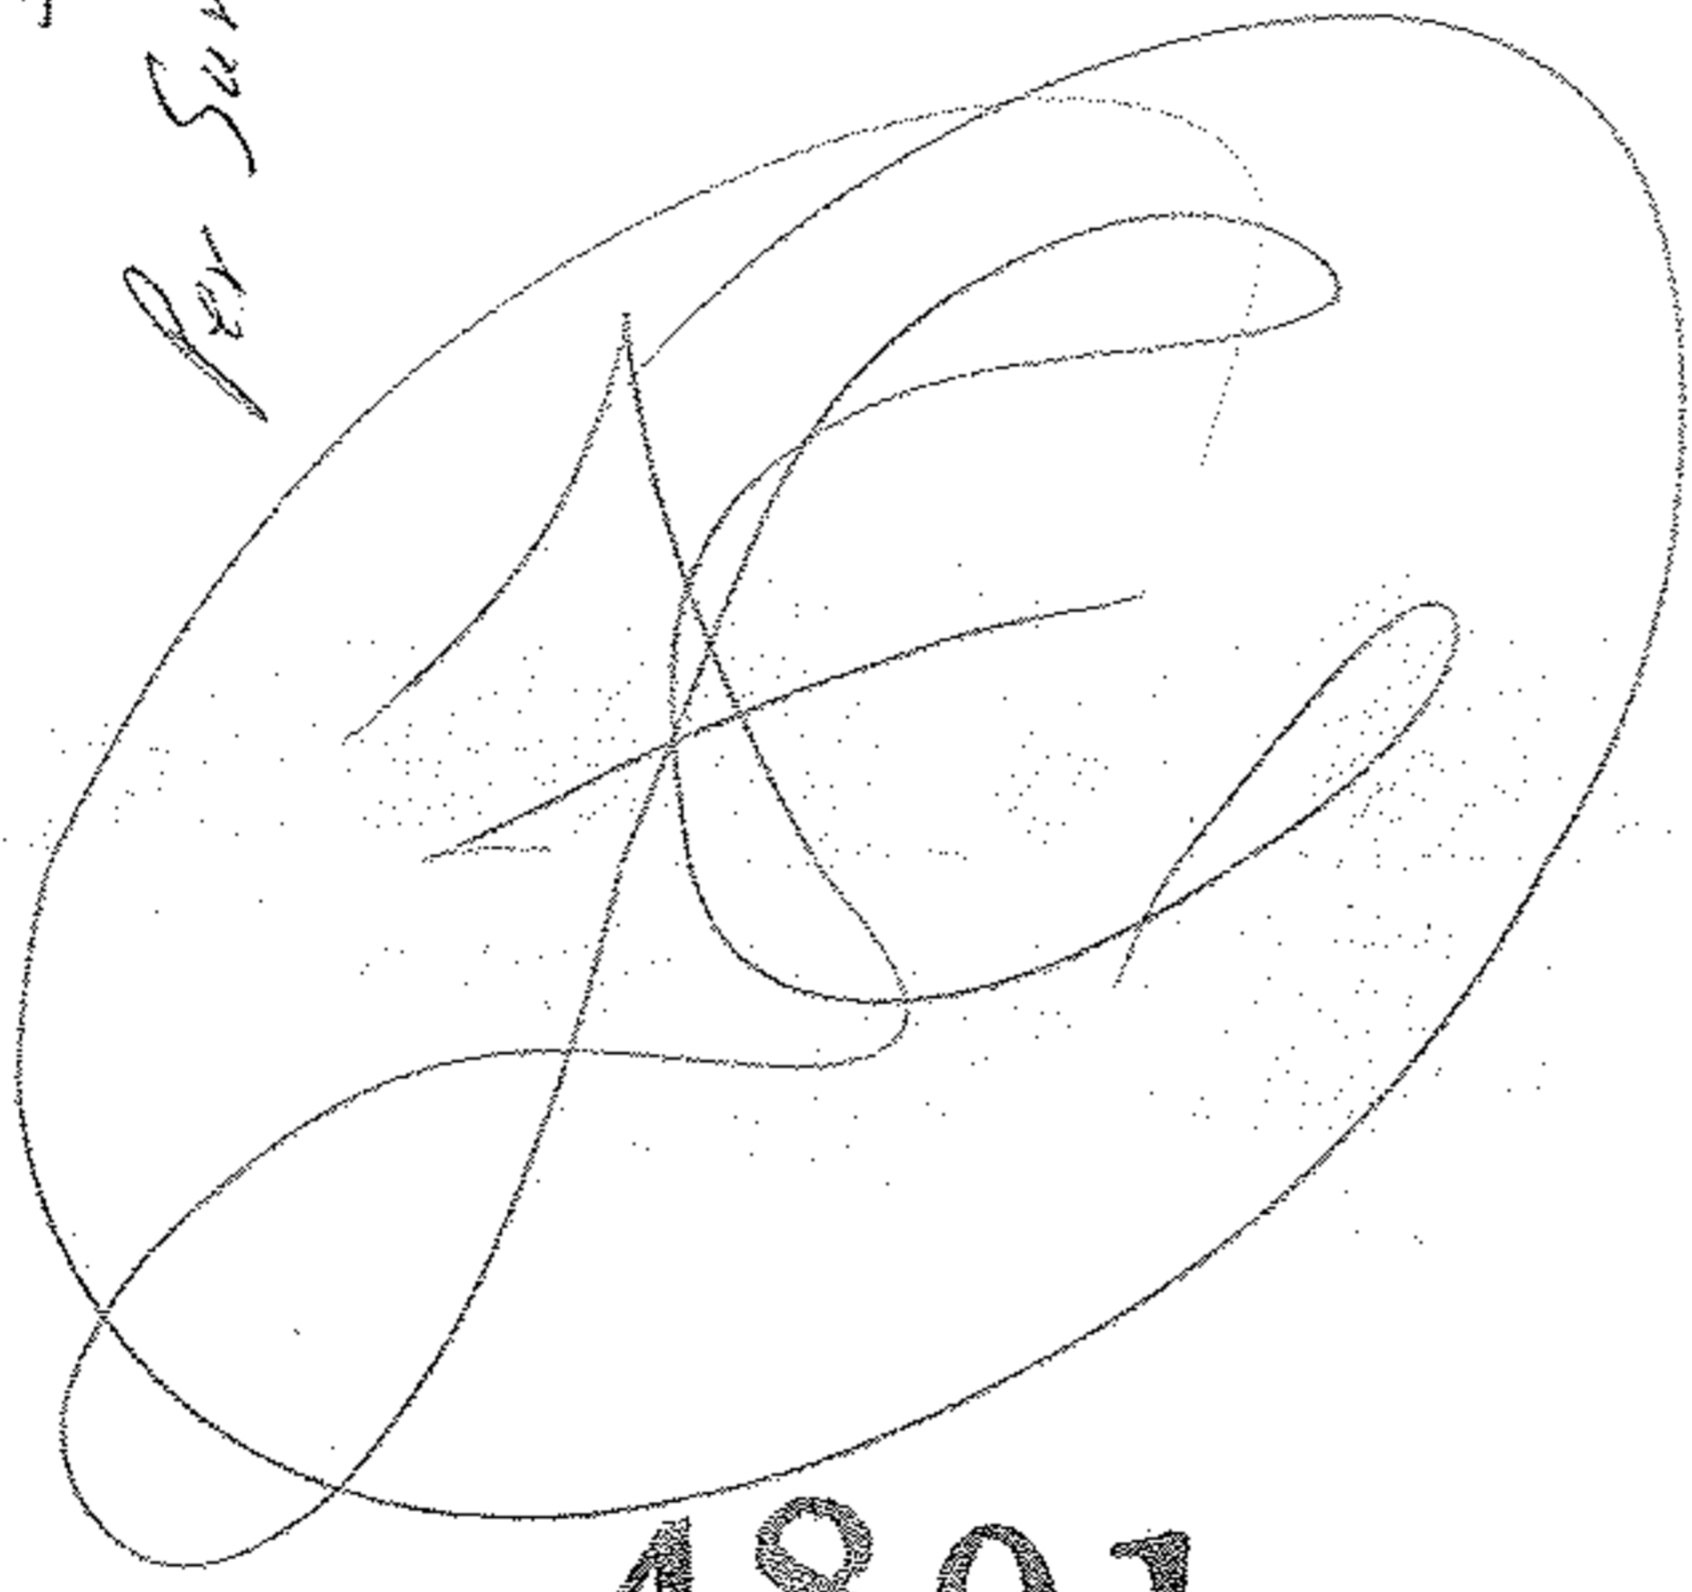

4801

APPROVED
LORAIN CO.
MAP DEPT.
DATE 3-29-71
1-00-002-C
BY *Hollis*

7-16-86
S.S

1355
1359.0
1354.22

-002
16.57A

59

693.45

4801

1635.48