


4819

4819

APPROVED
 LORAIN CO.
 MAP DEPT.
 DATE 4/5/71
 11-B
 BY R.J. Kellogg

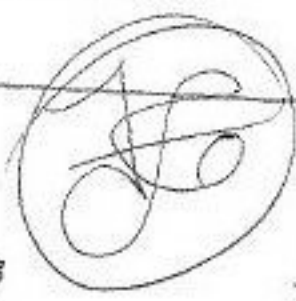


S.S. -033
 -037
 8-188-01A
 31.24

10

OBERVIN - CLEVELAND

72

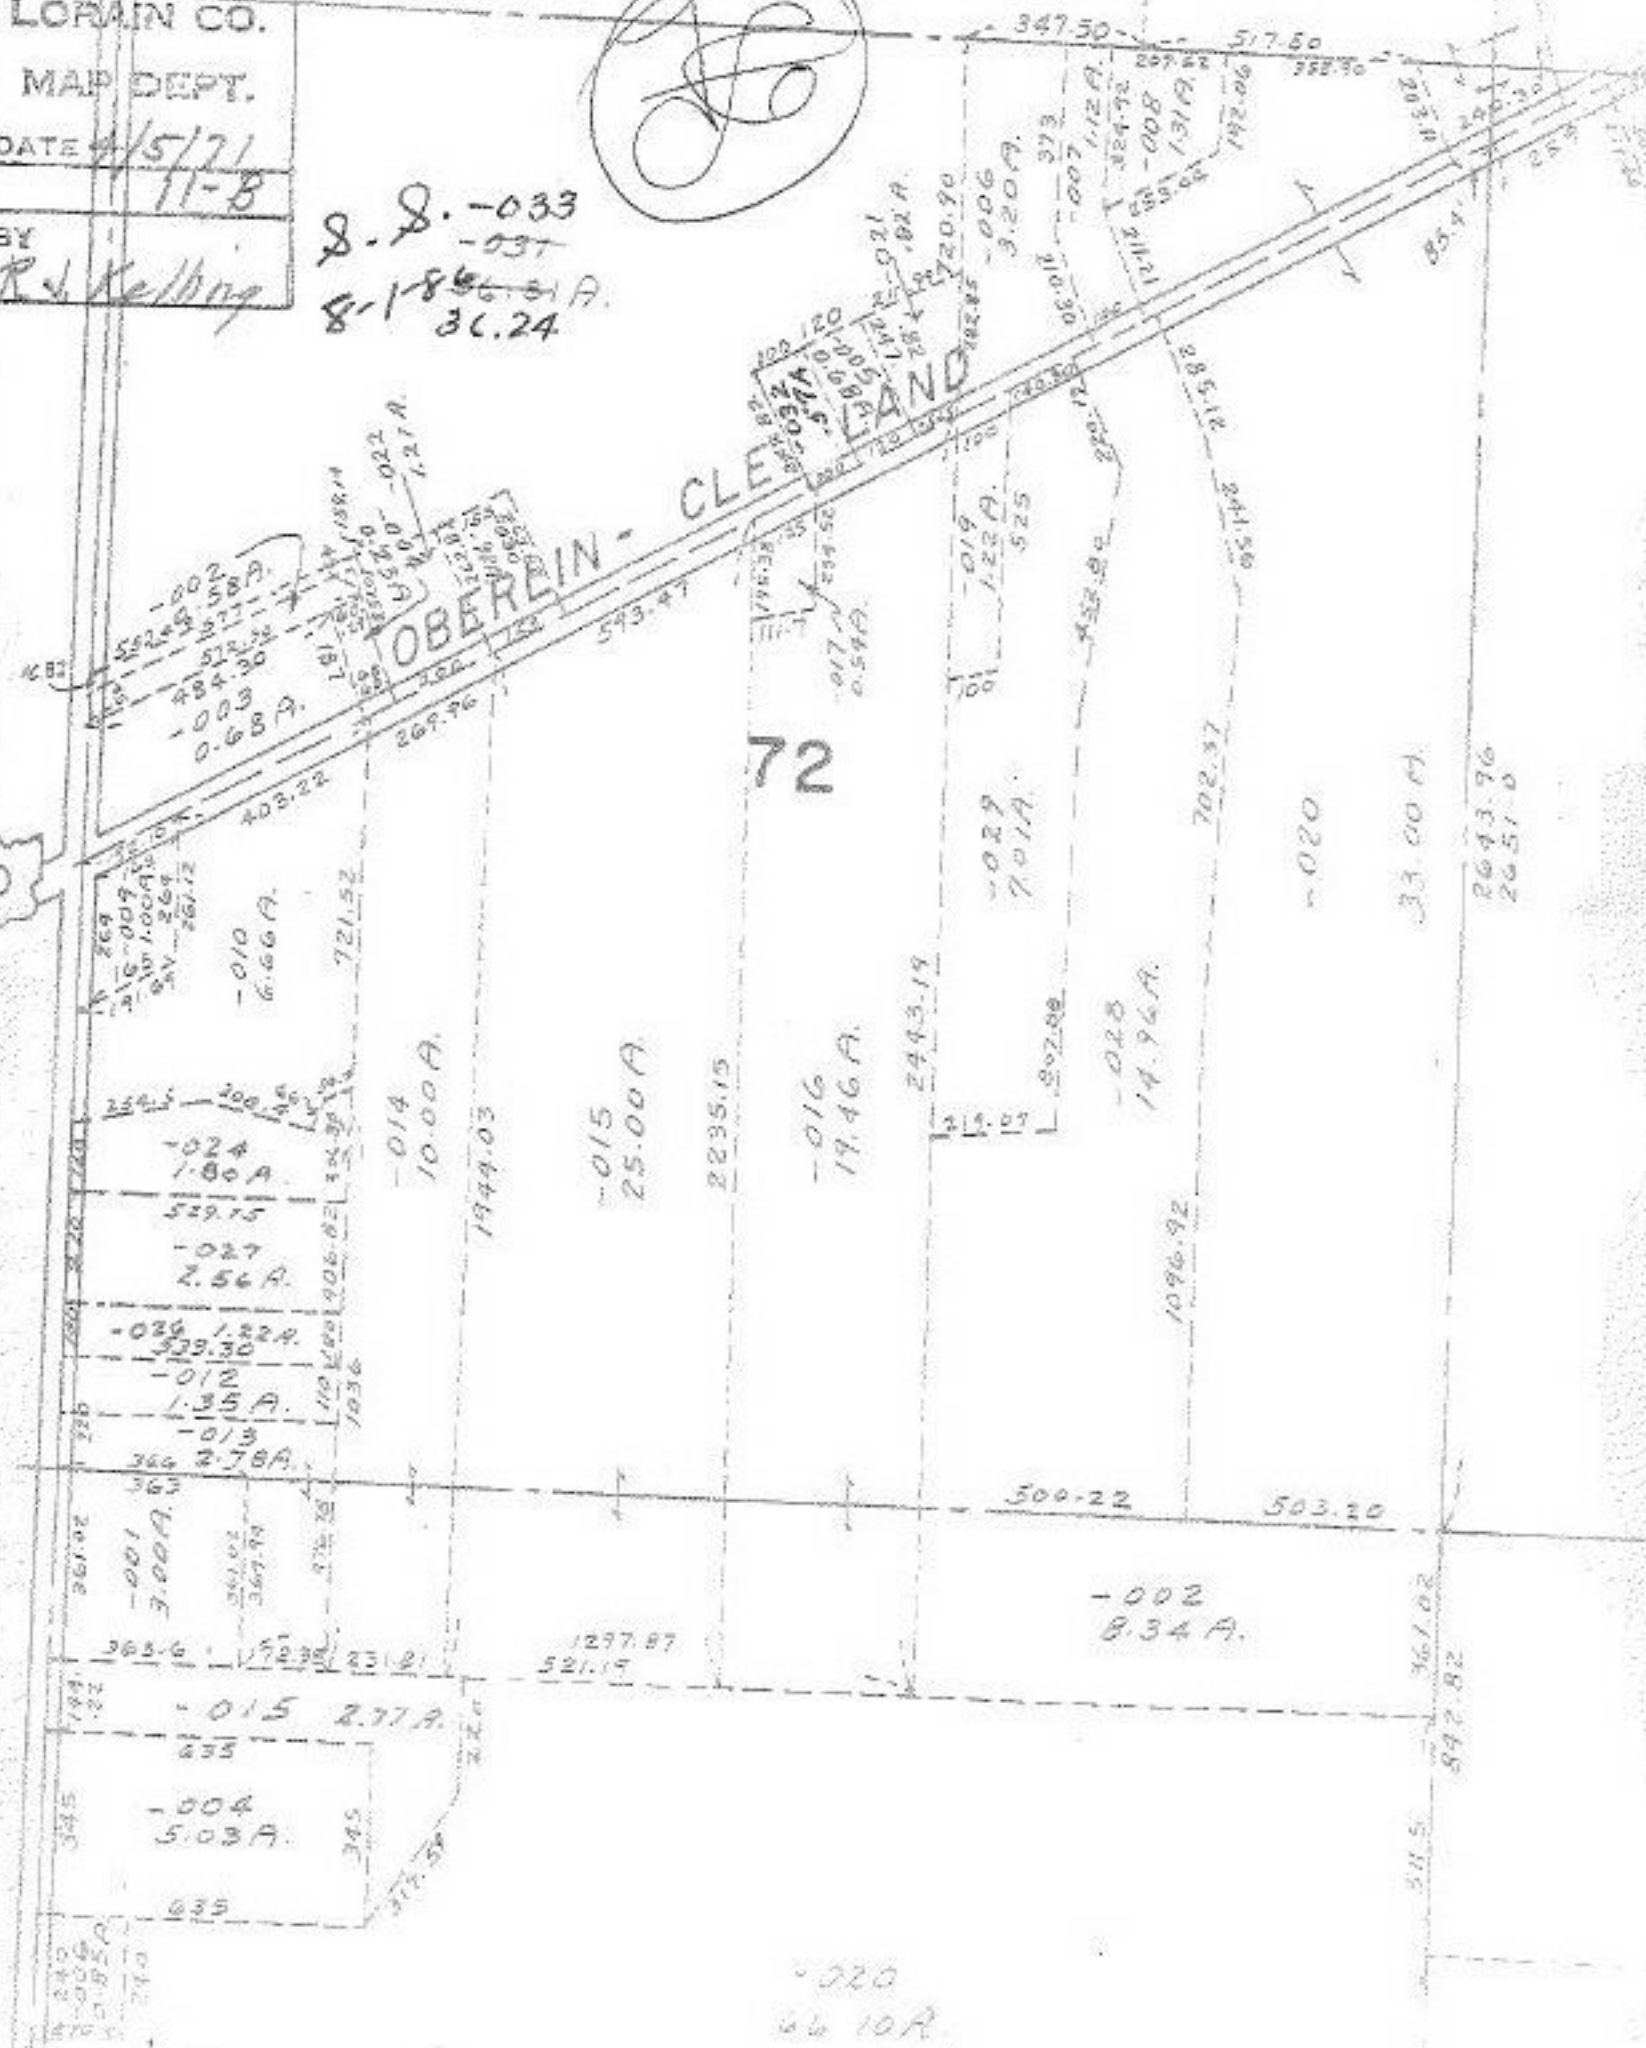

-020
 66 10R