

4822

1848.84
1051.05

SEE 7-18-86 L.L.


PT. -013
PT. 844A

1040.44
885.29

-037
2.01

313.19

-036
~~-012~~
759A.
558A.

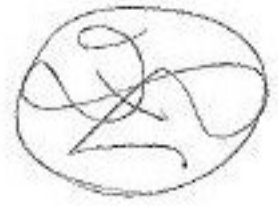

1124.03
612.06
574.97

574.97


487.03
1223.52
612.06

4822

7-18-86 L.L.

APPROVED
LORAIN CO.
MAP DEPT.
DATE 4/7/71
7-06-025-2
BY <i>R. Kelling</i>

MAY 7 1971

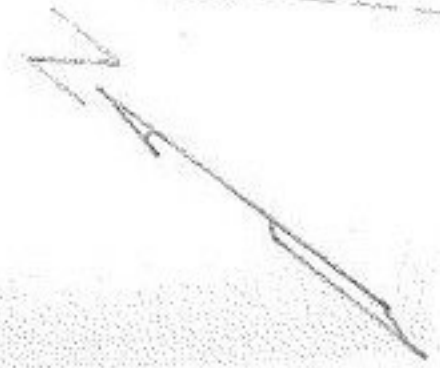

60
354.09