


SEE 4-G

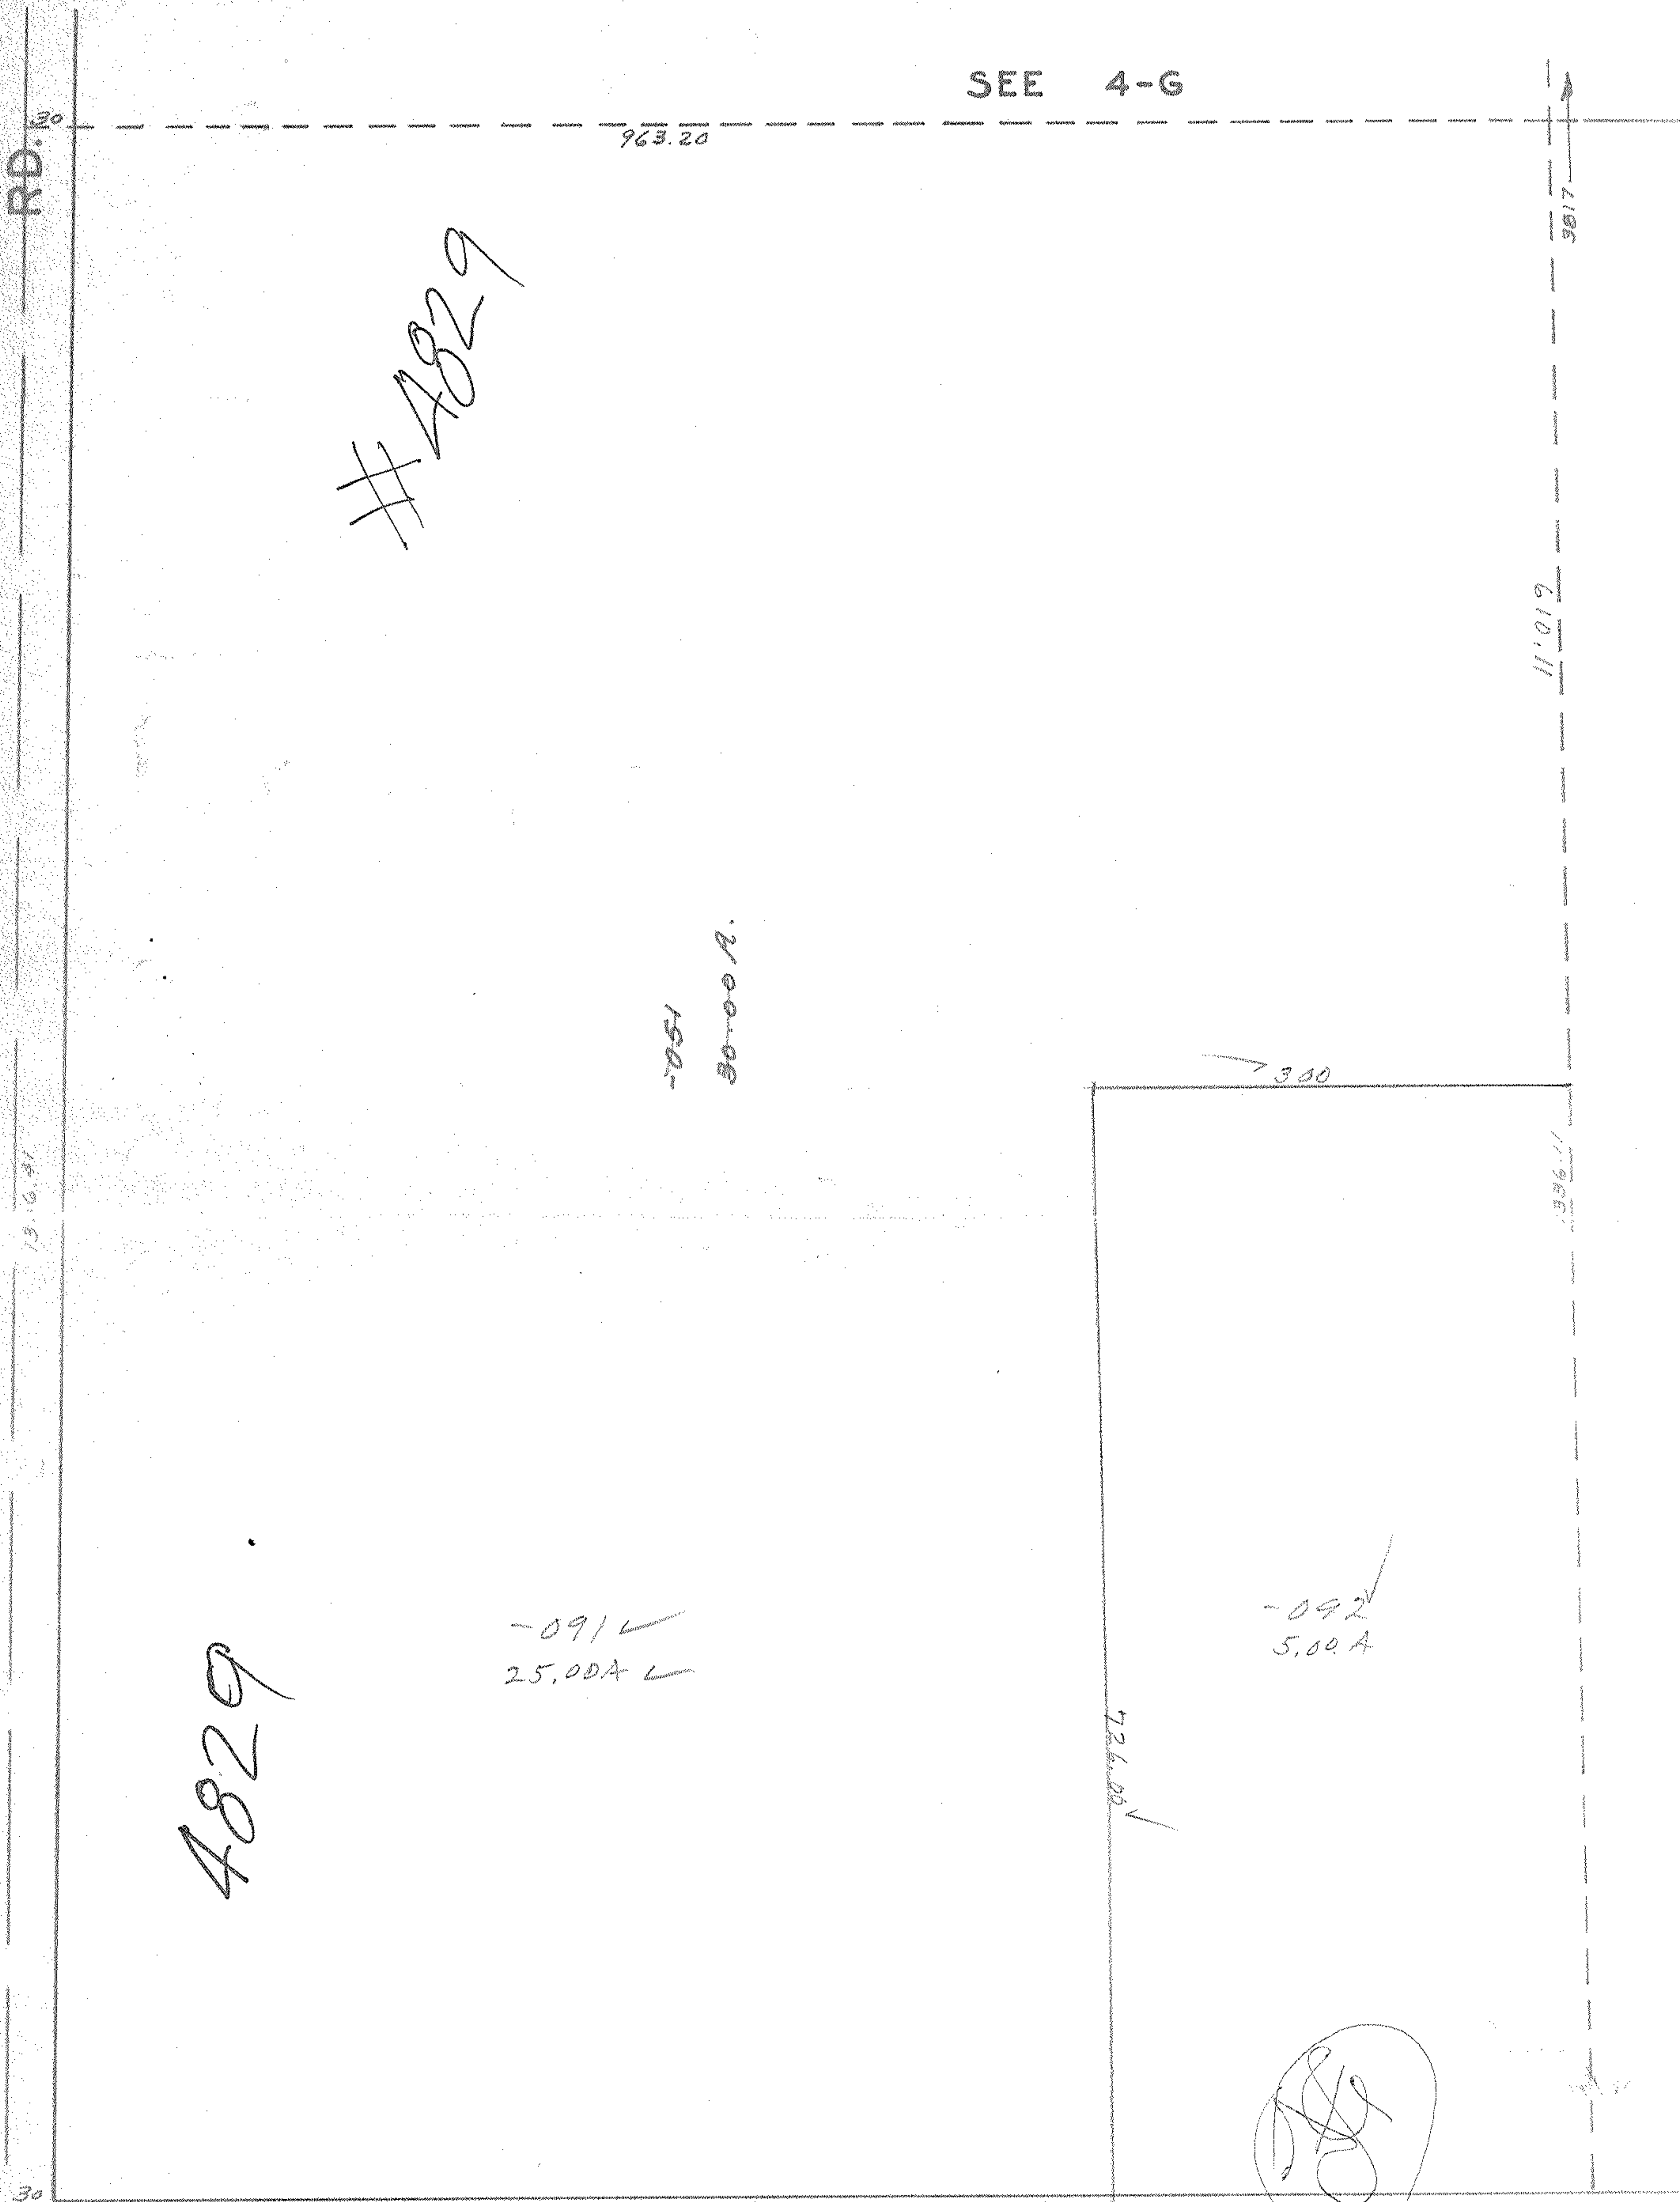

4829

#4829

-091 ✓  
25.00A ✓

-051  
30-00 A.

-092 ✓  
5.00A

*(Signature)*

CHESTER

4829

APPROVED  
 LORAIN CO.  
 MAP DEPT.  
 DATE 4/8/71  
 4-00-021-13

R. Kelling

17-18-86 L.L.