


BECKER

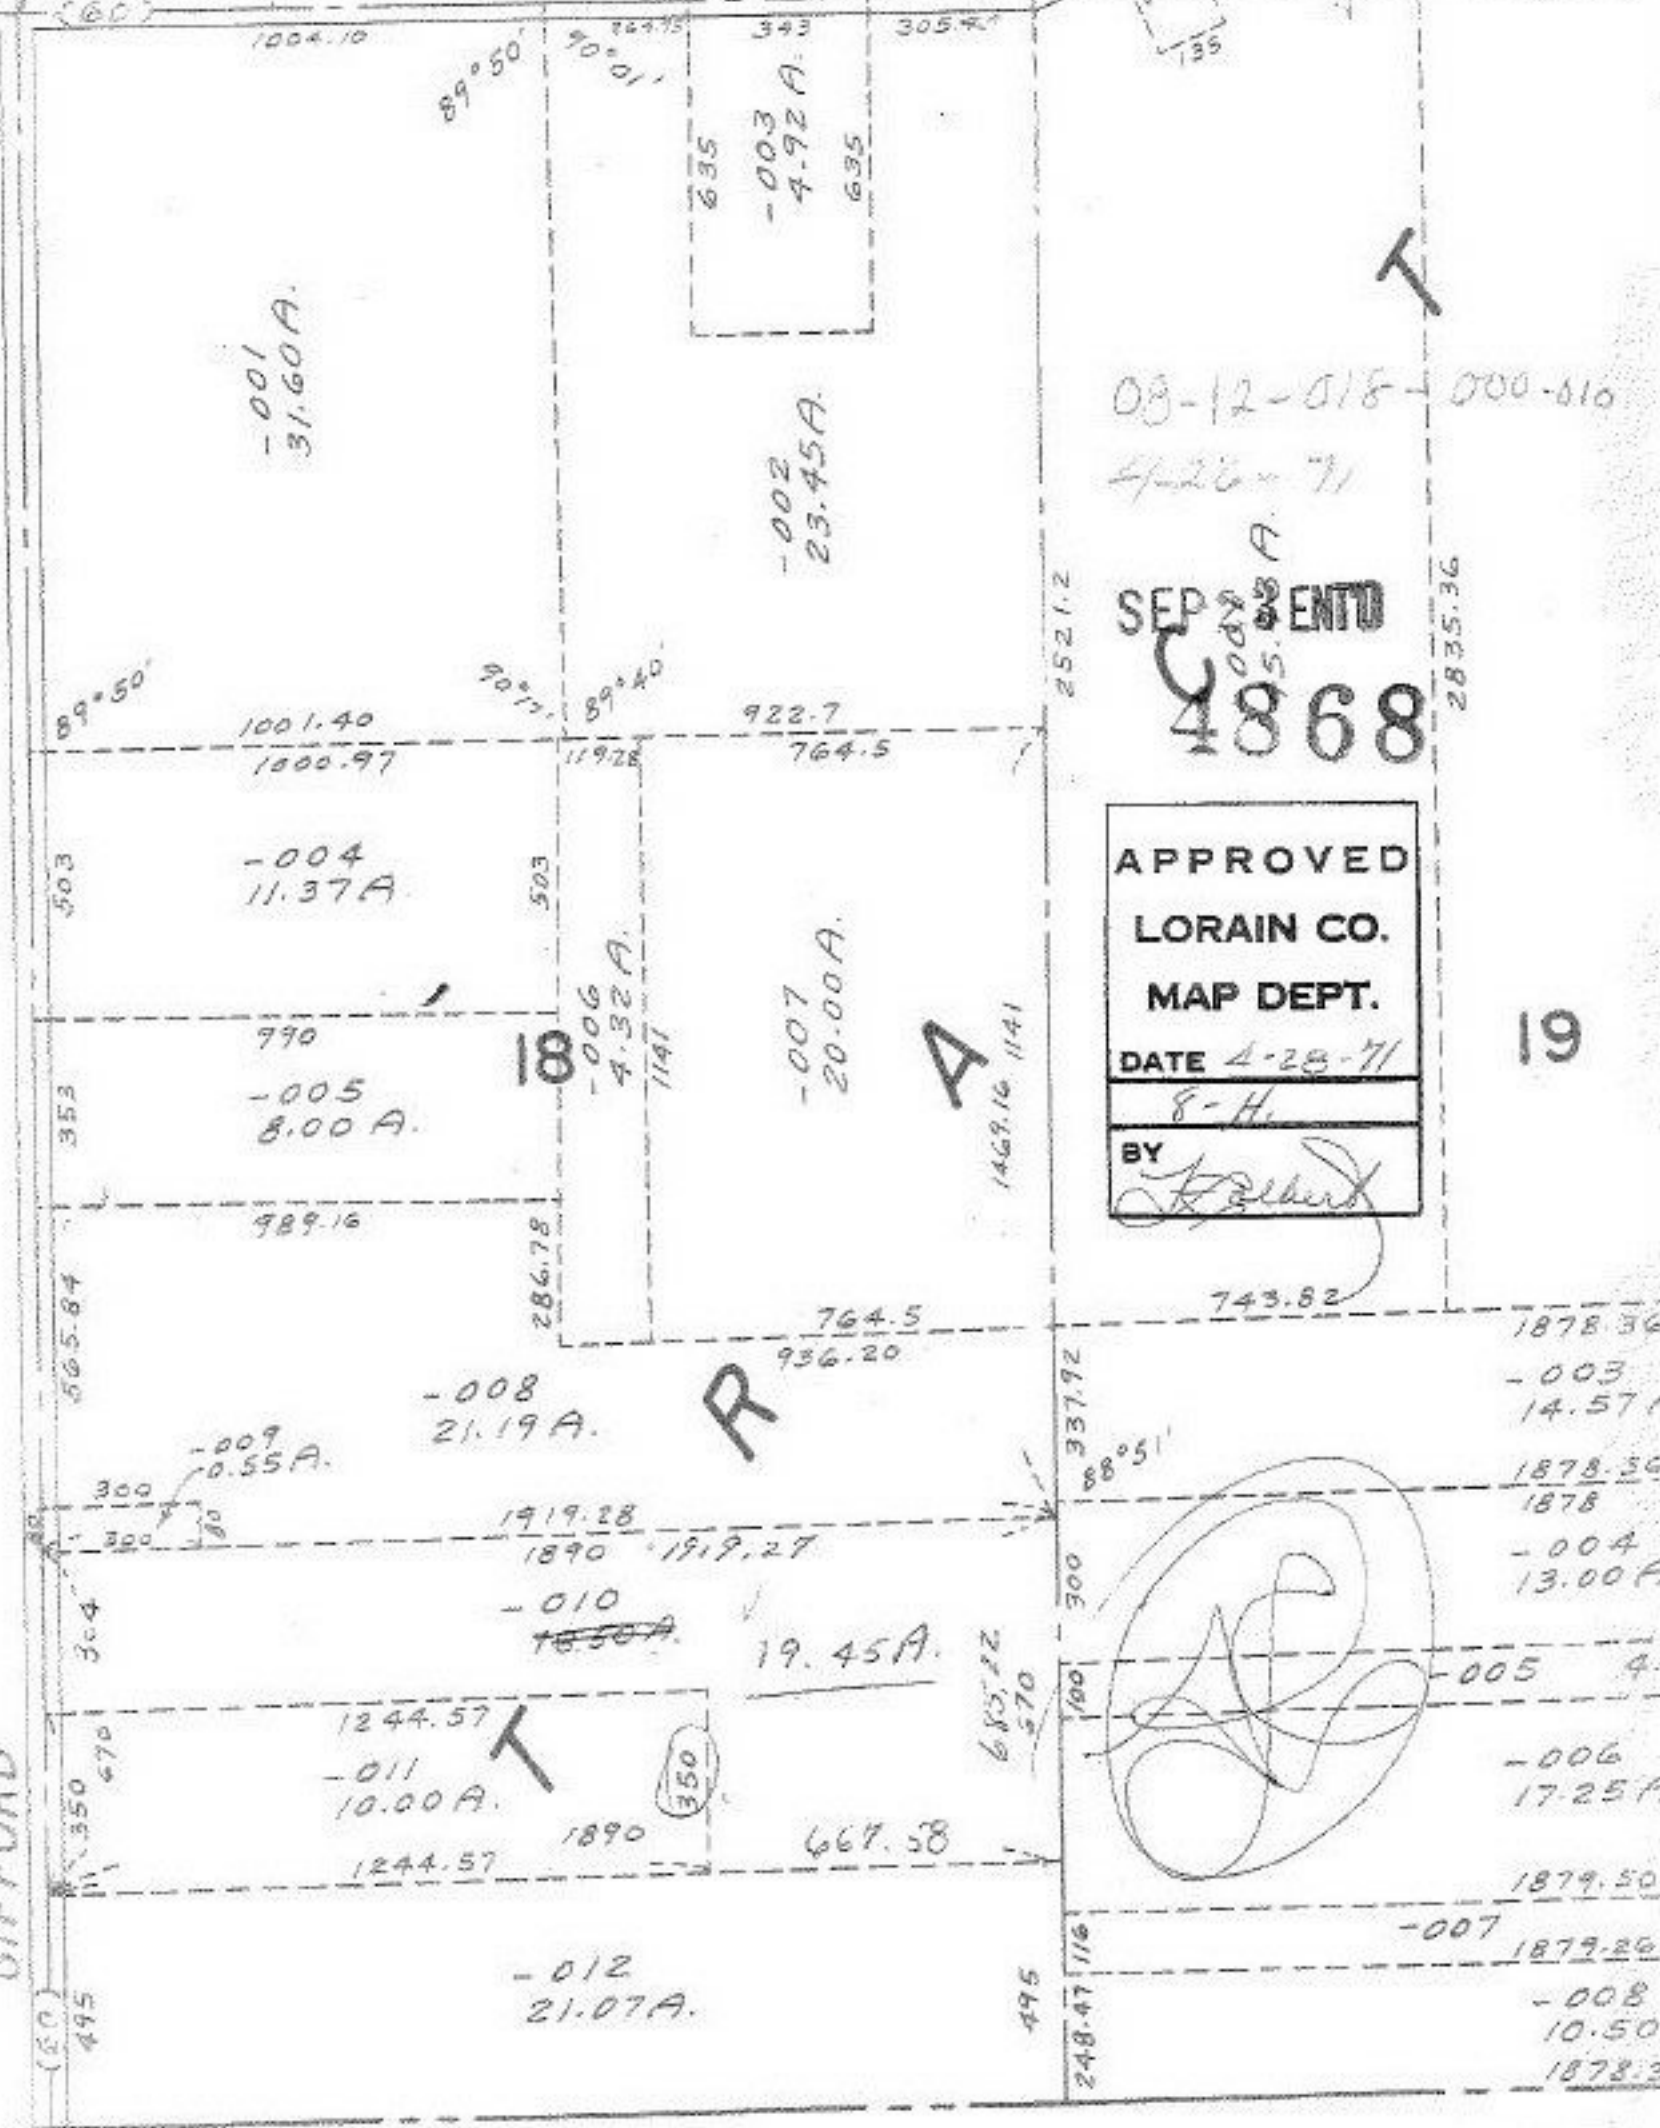

03-12-018-000-010

4-28-71

SEP 008 A
 4868
 2835.36

APPROVED
 LORAIN CO.
 MAP DEPT.
 DATE 4-28-71
 8-H
 BY *[Signature]*

19

WIFFORD

SEE 13