

4874

350

360

- 002
1.98A.

- 002
Pt. 05-00-013-102-001
Pt. 2898A
2.00A.

360

350

- 002
2.00A.

Acreage
Correction
175
708 - 404

300

80°45'


687 628

- 003
5.01A.

101

- 003
~~379A~~
354.77

617.79

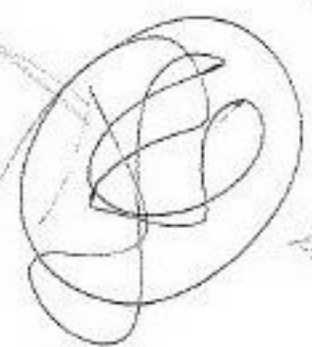


11874
APPROVED
LORAIN CO. MAP DEPT.
DATE 4-29-71
5-00-013-A
BY *[Signature]*

MAY 14 1971

- 005
1.60A.

add to
Dap.

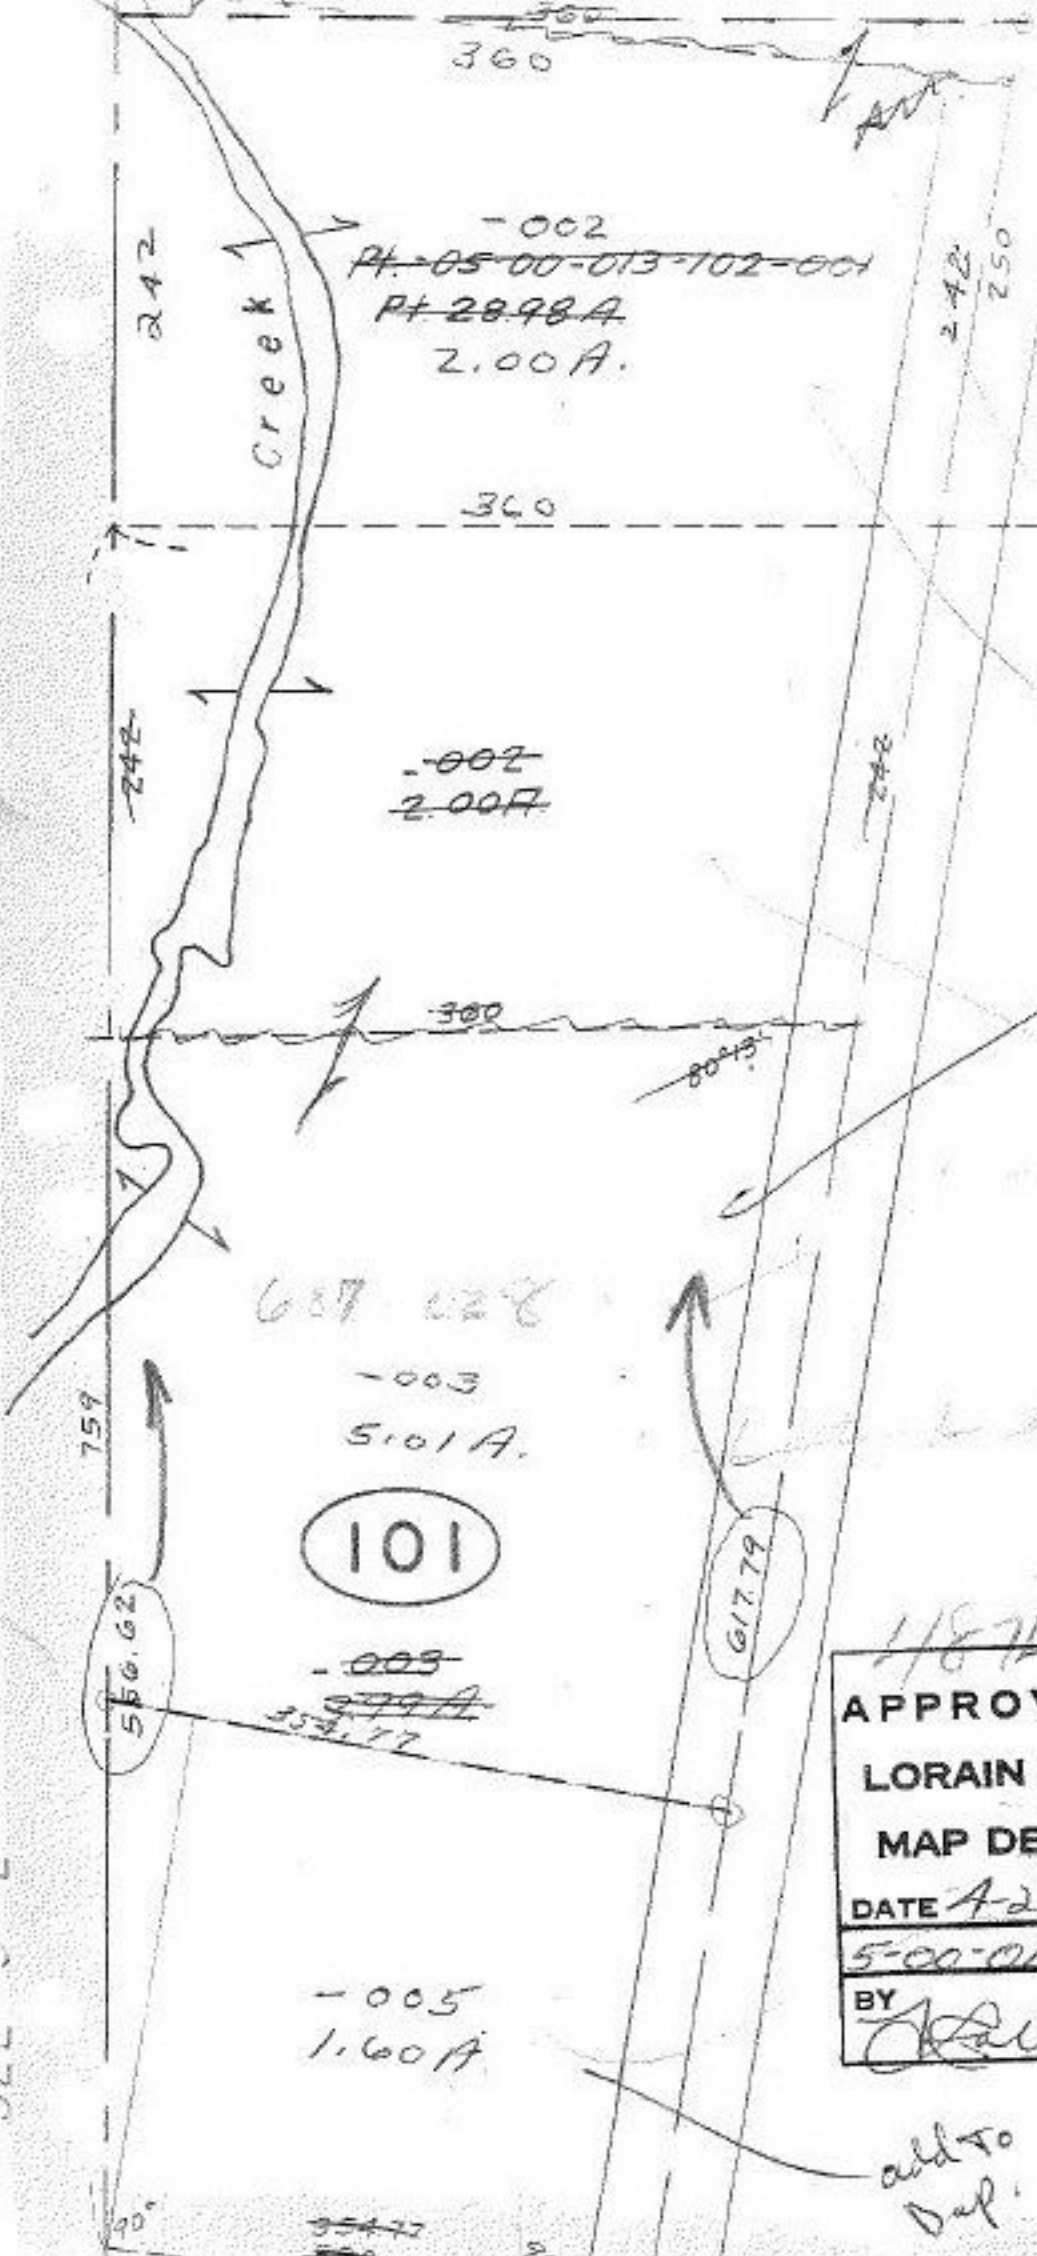

90°

354.77