

4895


4895

APPROVED  
 LORAIN CO.  
 MAP DEPT.  
 DATE  
 BY

APPROVED  
 LORAIN CO.  
 MAP DEPT.  
 DATE 5/10/71  
 4-00-003 A9 E  
 P.L. McElroy



2

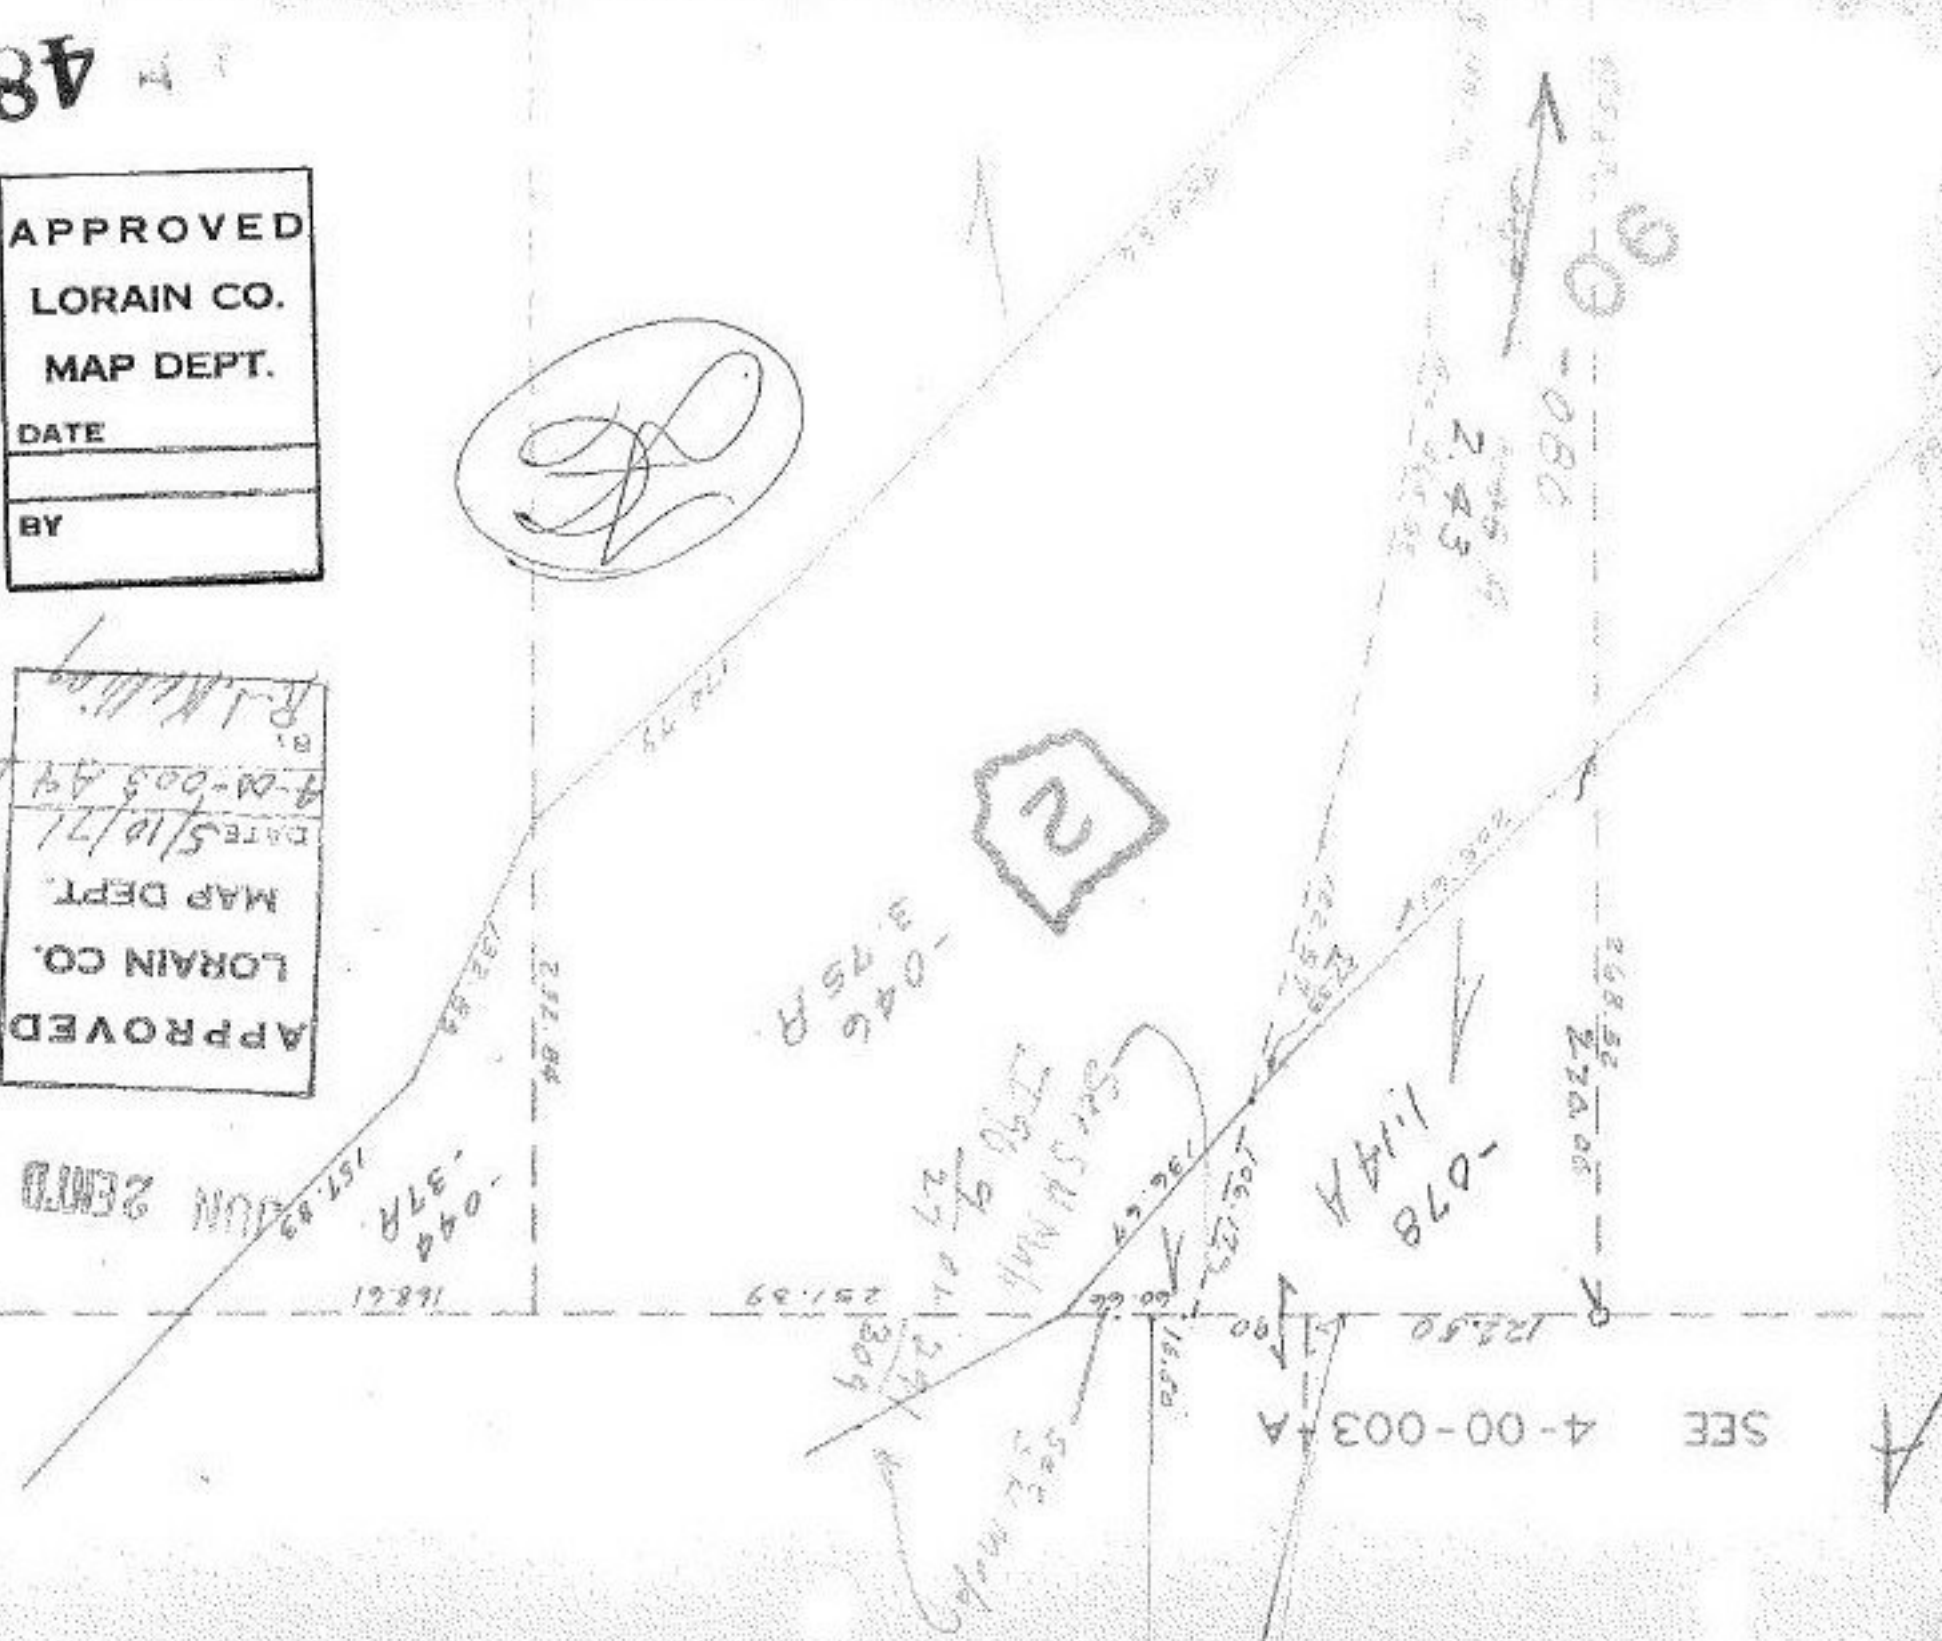

A

B

SEE

A