

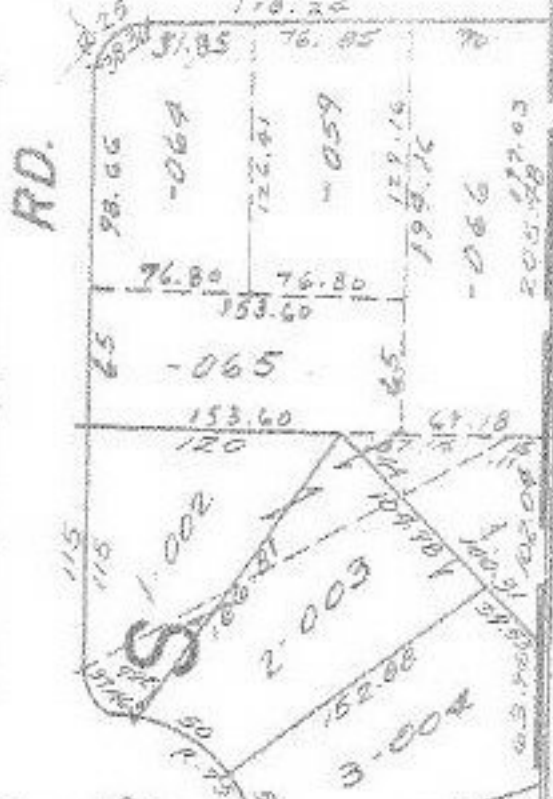
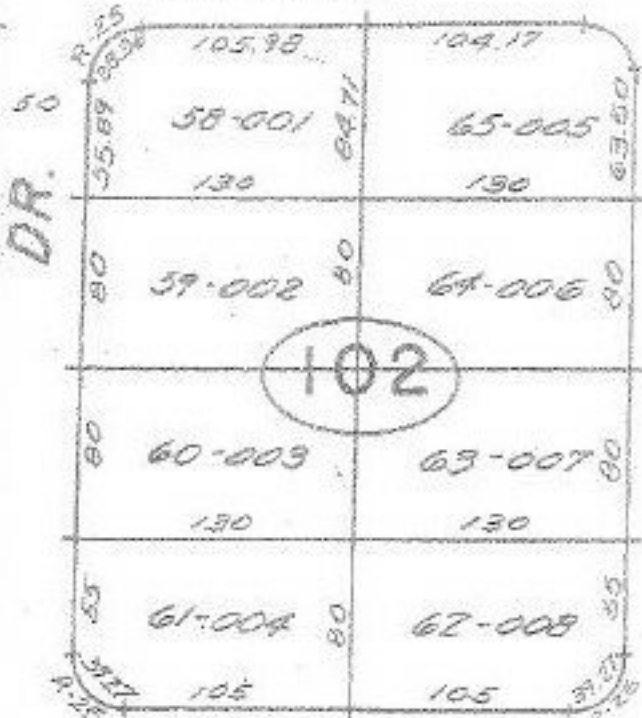
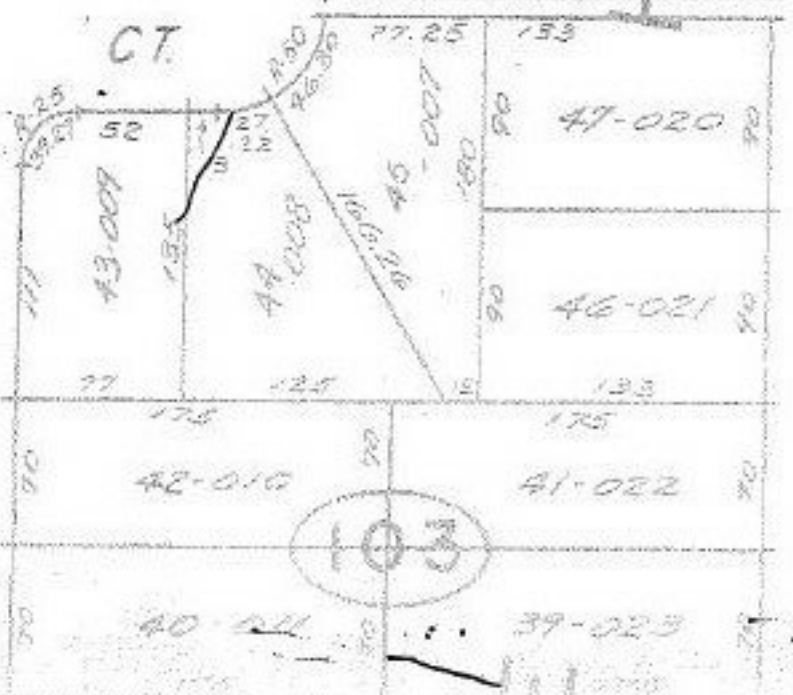


MEISTER

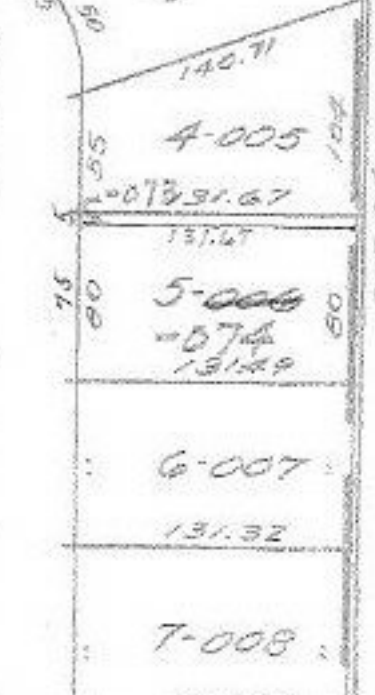

REINWALD

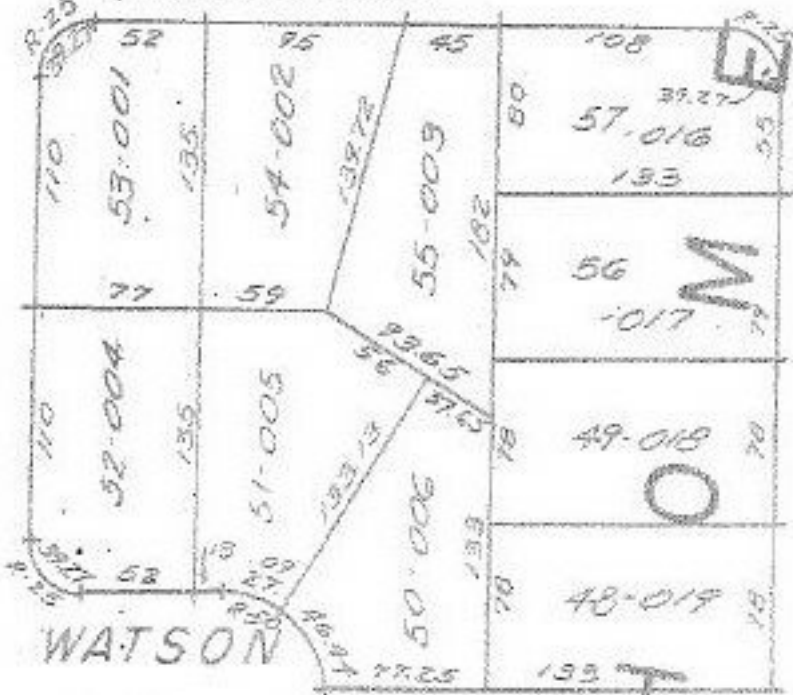

4896

JUN 2 1971
 JUN 2 1971
 4896

APPROVED
 LORAIN CO.
 MAP DEPT.
 DATE 5/10/71
 2-07-012-B
 BY

DR.