

4901

~~2789.85~~
2767.45

2789.85
22.40

2767.45

-006
-001
78.00 A.
77.86

88° 58'
9 27 22

1234.80

1234.40
2469.20

1587.20

882.00

CORP.

2786.6

22

-007
-002
39.49 A.
39.81

1587.20
1234.40

352.80

1587.20


1234.40

352.80

9-00-023-A

JUN 3 1976
4901

-003
39.48 A.

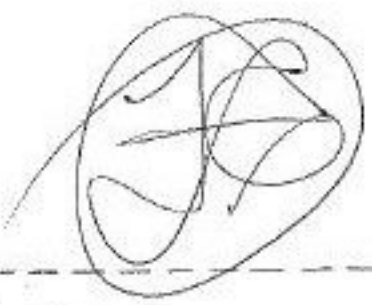

882.00

2783.4

-004
12.00 A. Dup. 13.00 A. Map.

APPROVED
LORAIN CO.
MAP DEPT.
DATE 5/12/76
9-A
BY R. J. Kelling

1234.2

1234.8

203.4

349
-003
1000
36

203.4

15.26

-001
16.25 A.

23