


00-013-B

012-B

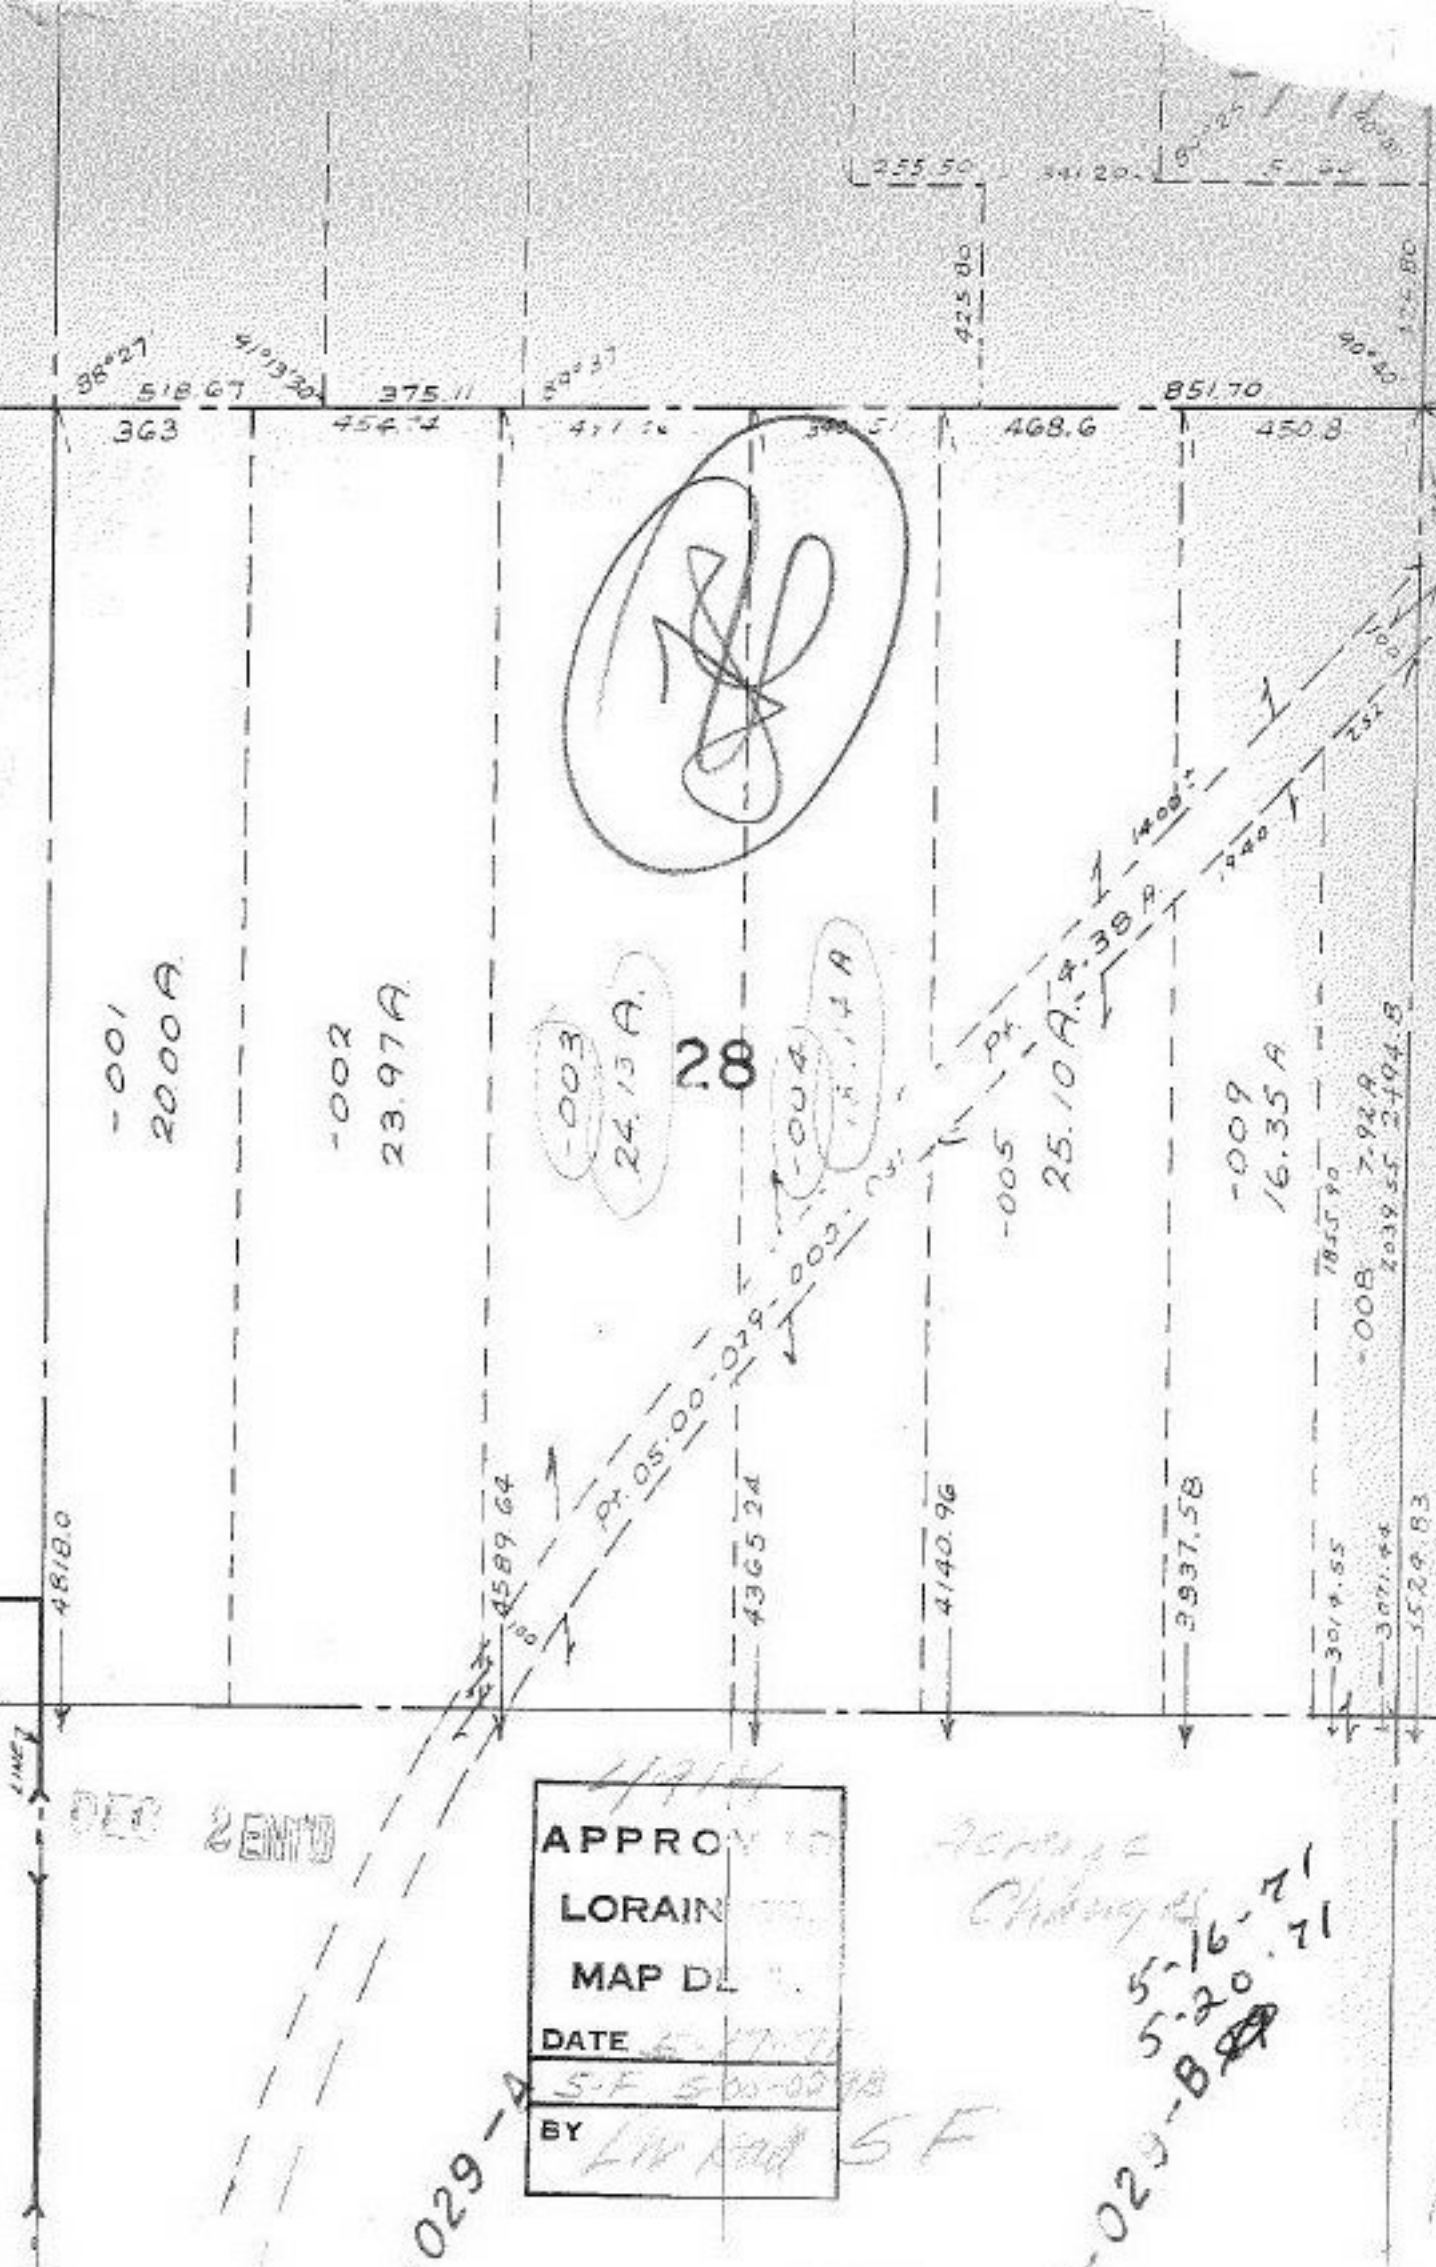

DEC 2010

APPROVED
LORAIN
MAP DL
DATE 5-17-11
S-F 500-02-118
BY LK Rad SF

5-16-11
 5-20-11
 -029-B

-029-A

-029-B