

4922

4/9

-001
14.28A

2220

-007

-008
23.68

~~23.98~~ A
19.50


Acreage Change
By Dead Calculation

2040

PT 031

JUN 10 1907

4922
 APPROVED
 LORAIN CO.
 MAP DEPT.
 DATE 5-19-7
 5-00-029A
 BY L W Hall

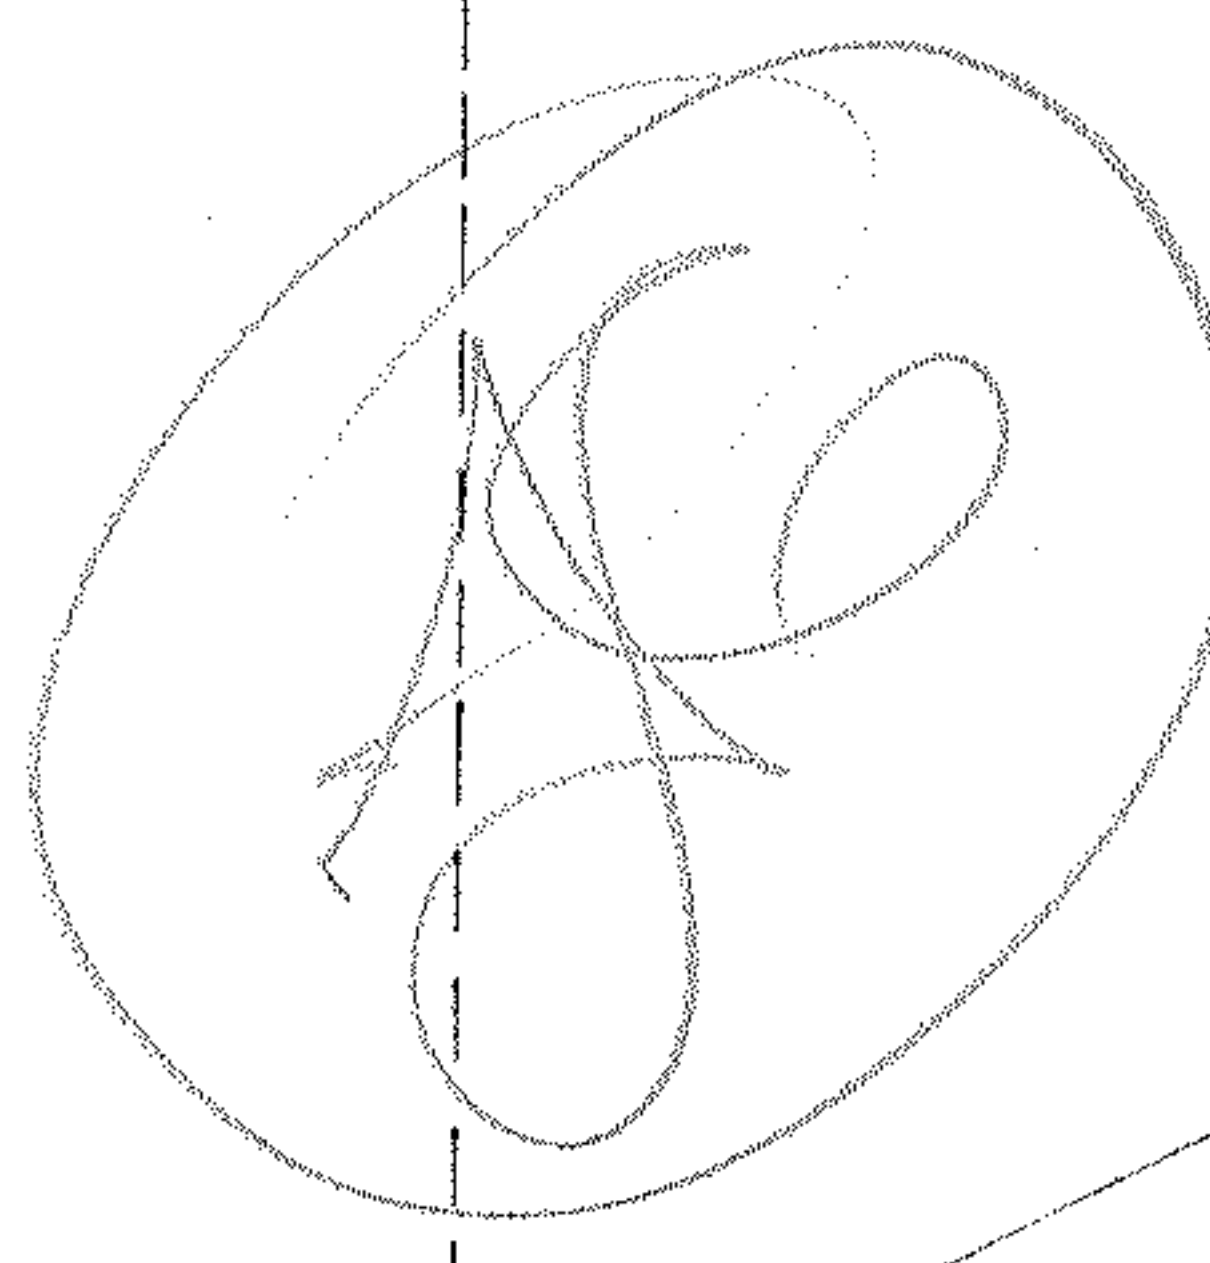

128.71


-005
1.89A

462.73

MILAN ELYRIA

-018
2.93A

5-00-029

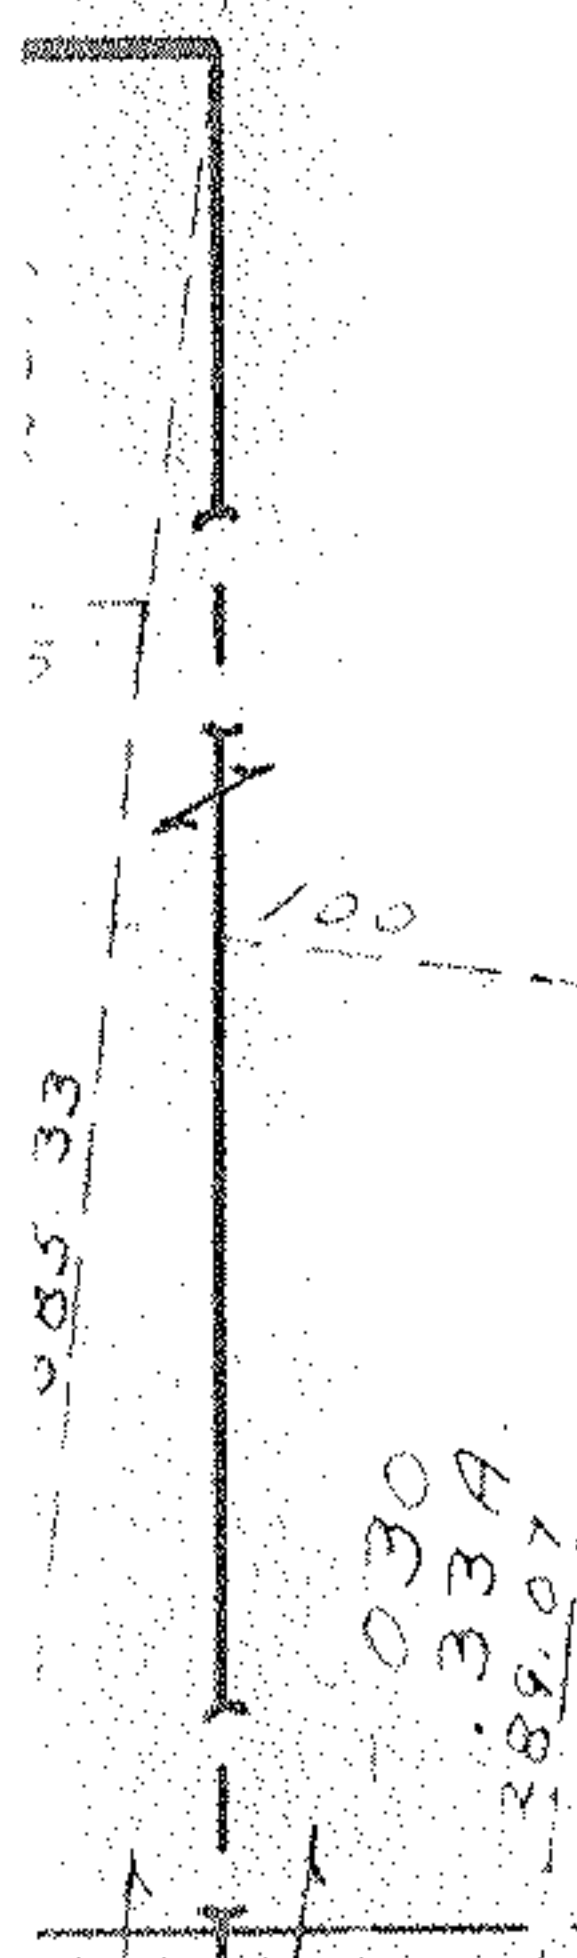

535.52

206
183.40

492.80

125

130

244

53.75

137.83

134

190.62