

1977 ASBLY FINE 388.00

2202.88 from N. Line 0112


Pt 19-04-012-000  
- 027  
38.23

1163.21

Pt. -025  
Pt 48-04-9.

JUN 14 ENT'D

-026  
9.84 AC

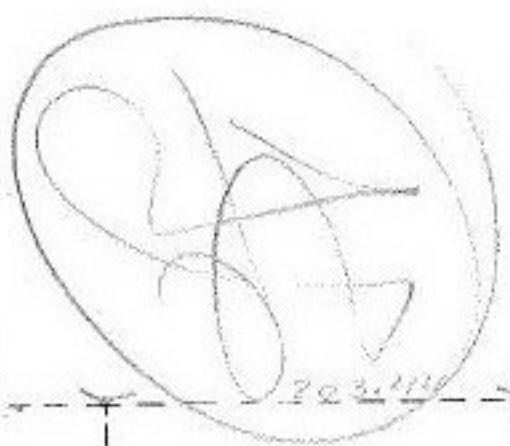

186.73  
148.5

203.111

427.0

712.42

263.50

-023  
654.

148.5  
187.75

-006

8.8.  
8-4-80

19-04-012B

6/14/80

357.98