

JUN 14 1971

RD.

4941

APPROVED
 LORAIN CO.
 MAP DEPT.
 DATE 5-25-71
 16-F
 BY *Hallbert*

✓
 -012
~~52.73A~~
 43.64A.

-007
 9.19A.

✓
 -011
 9.09A

-009
 8.08A


-002
 35.00A.

76

-003
 25.00A.

-006
 2.94A.

-005
 32.06A.

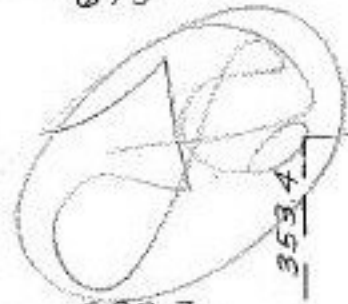

92.8

001
00A.

2694.8

77

002
0.57A.

2692.4

2791.8

660

1164.7

329.75

968.88

525.53

673

300

300

300

300

247.7

353.4

192.6

227.7

1317.38

300

1184.79

300

2014.3

1779.80

1626.9

683.7

142B

386

649

160