


116

4/9/49

1719.59
1720.62

-002
7.00 A.

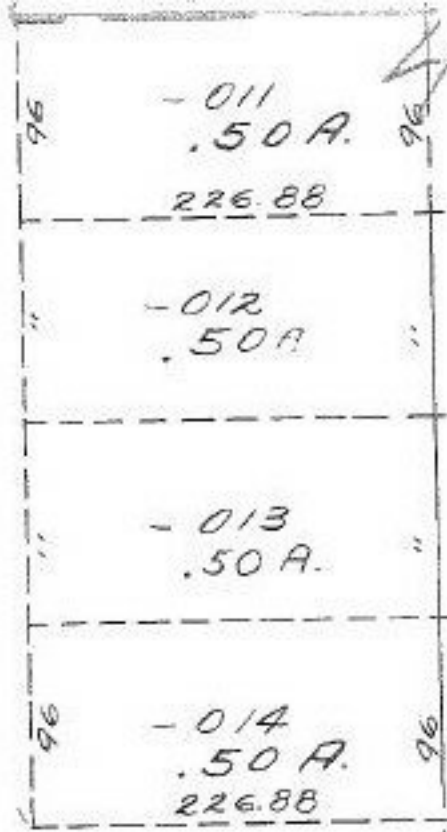

JUN 15 1970

4/9/49
APPROVED
 LORAIN CO.
 MAP DEPT.
 DATE 5-27-71
 7-00-021 D
 BY L W Hall

7-18-86
L.L.

-021
~~3.24 A.~~
1.82

-017
1.17 A.

-020
1.42 A.

243.77 L
LAWSON

20


RD.
233.86 L

07-00-021 D

Pt. -042
Pt. 2.26 A.
Pt. 2.24 A.

039 A.
9.56

Pt. -040 A.
Pt. 3.00 A.

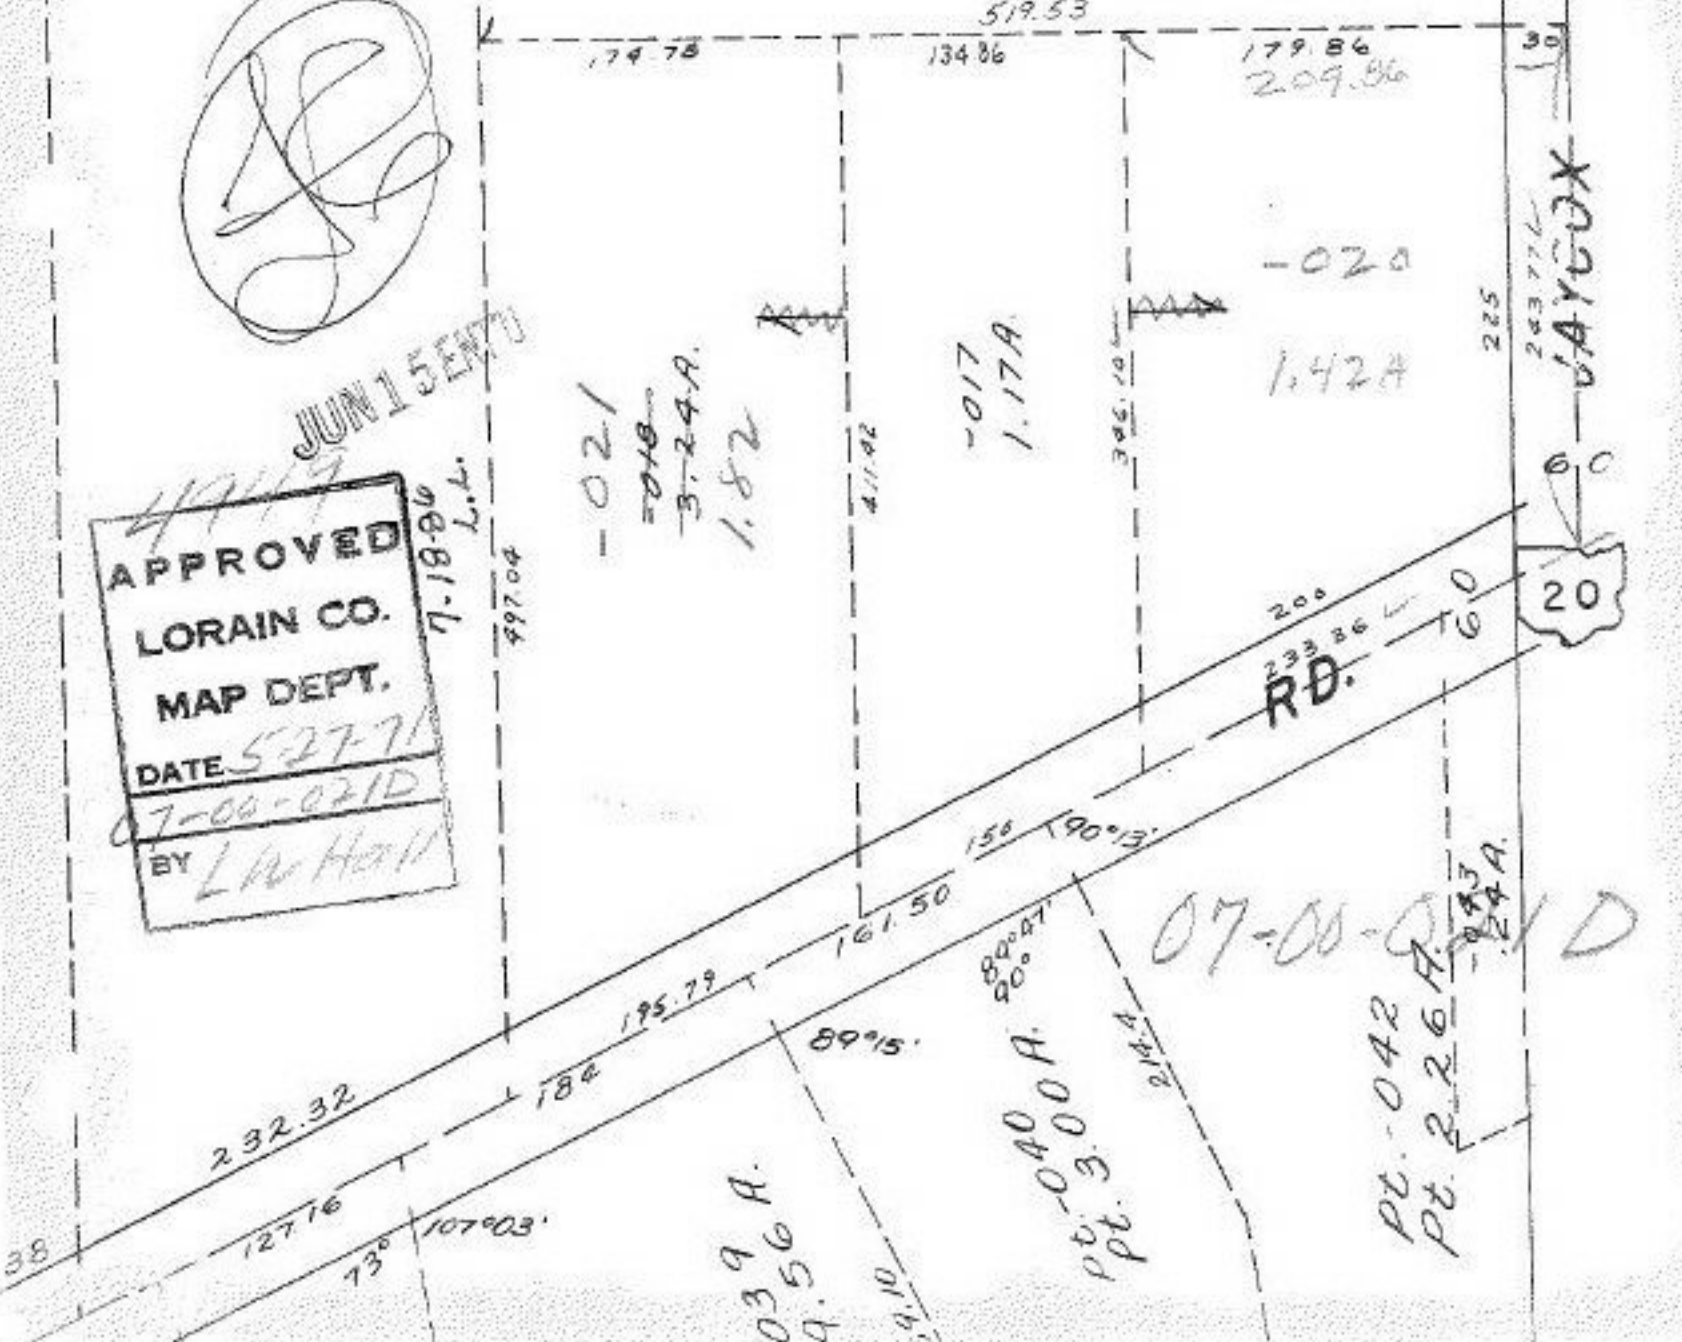

SEE 7-00-016-A