


LOTS 85,
TRACT 15

T W P.

HENRIETTA

SCALE: 1" = 400'

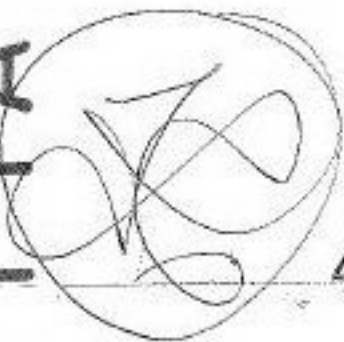


4952

JUN 15 1907

APPROVED
 LORAIN CO.
 MAP DEPT.
 DATE 6/11/71
 8-B 18-C
 BY R. J. Kall...

6

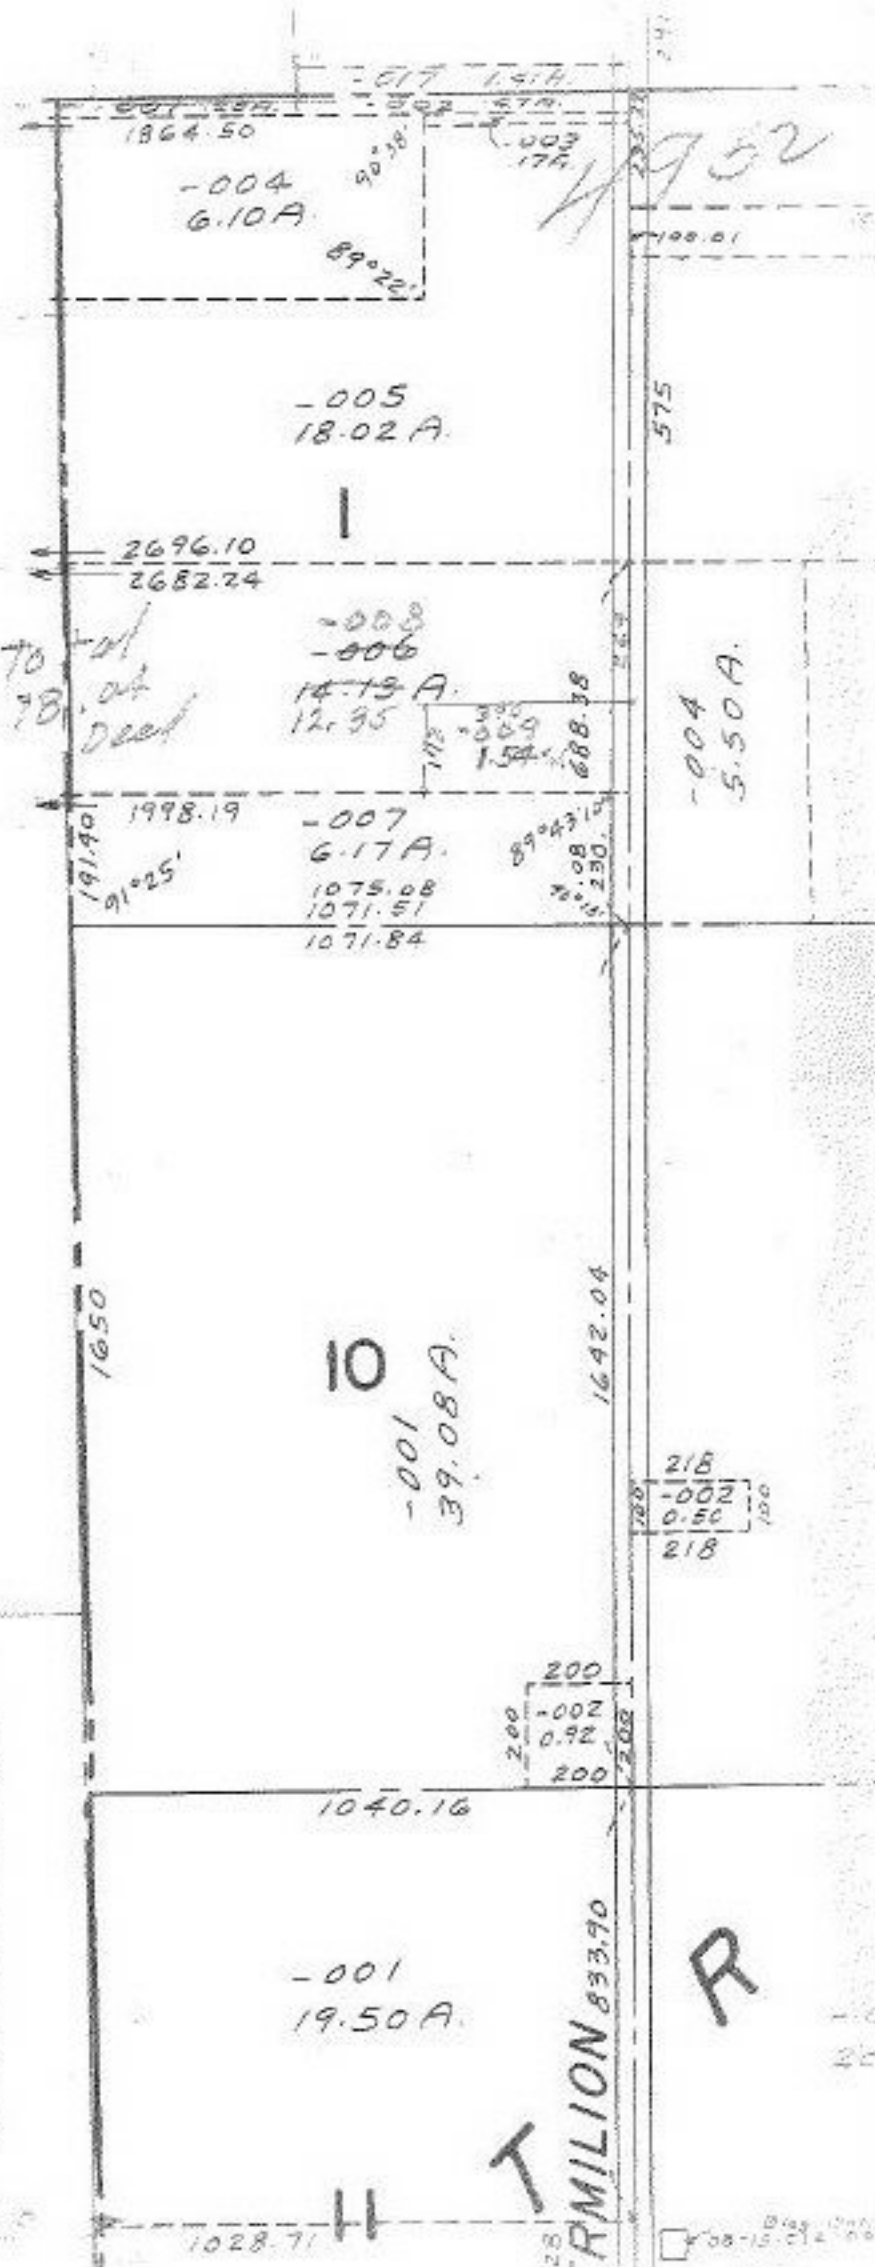

4952

R

RMILION 83370