

SEE '8-A

RD.

18

(60)

122°

215

-009
8.45A.

50.50A.
100.
7.4

-001
10.45A. (502)

R. R

RD.

(60)

1863.69

✓
-013
-011
124.49
111.72

477.77

Moved down
of corner
map

Check
location
of this point

960.91
240.91

1234.91

JUN 15 1971

4954


-012
12.77A.

1277.17

39

-005
28.00A.

-006
50.00A.

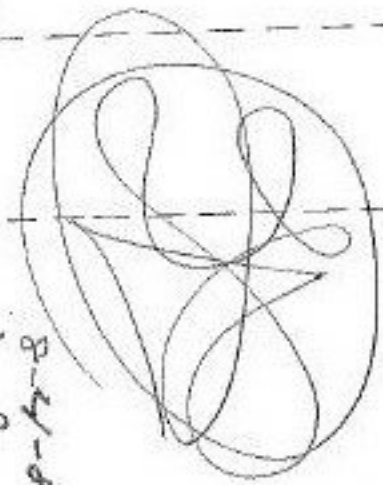

APPROVED
LORAIN CO.
MAP DEPT.
DATE 6/11/71
18-E
BY R. Melling

J. S. B.
8-4-82

4954