


109

JUN 25 1971
4970
200
2.73 A
7-16-71

APPROVED
LORAIN CO.
MAP DEPT.
DATE 6/9/71
BY R.J. Williams

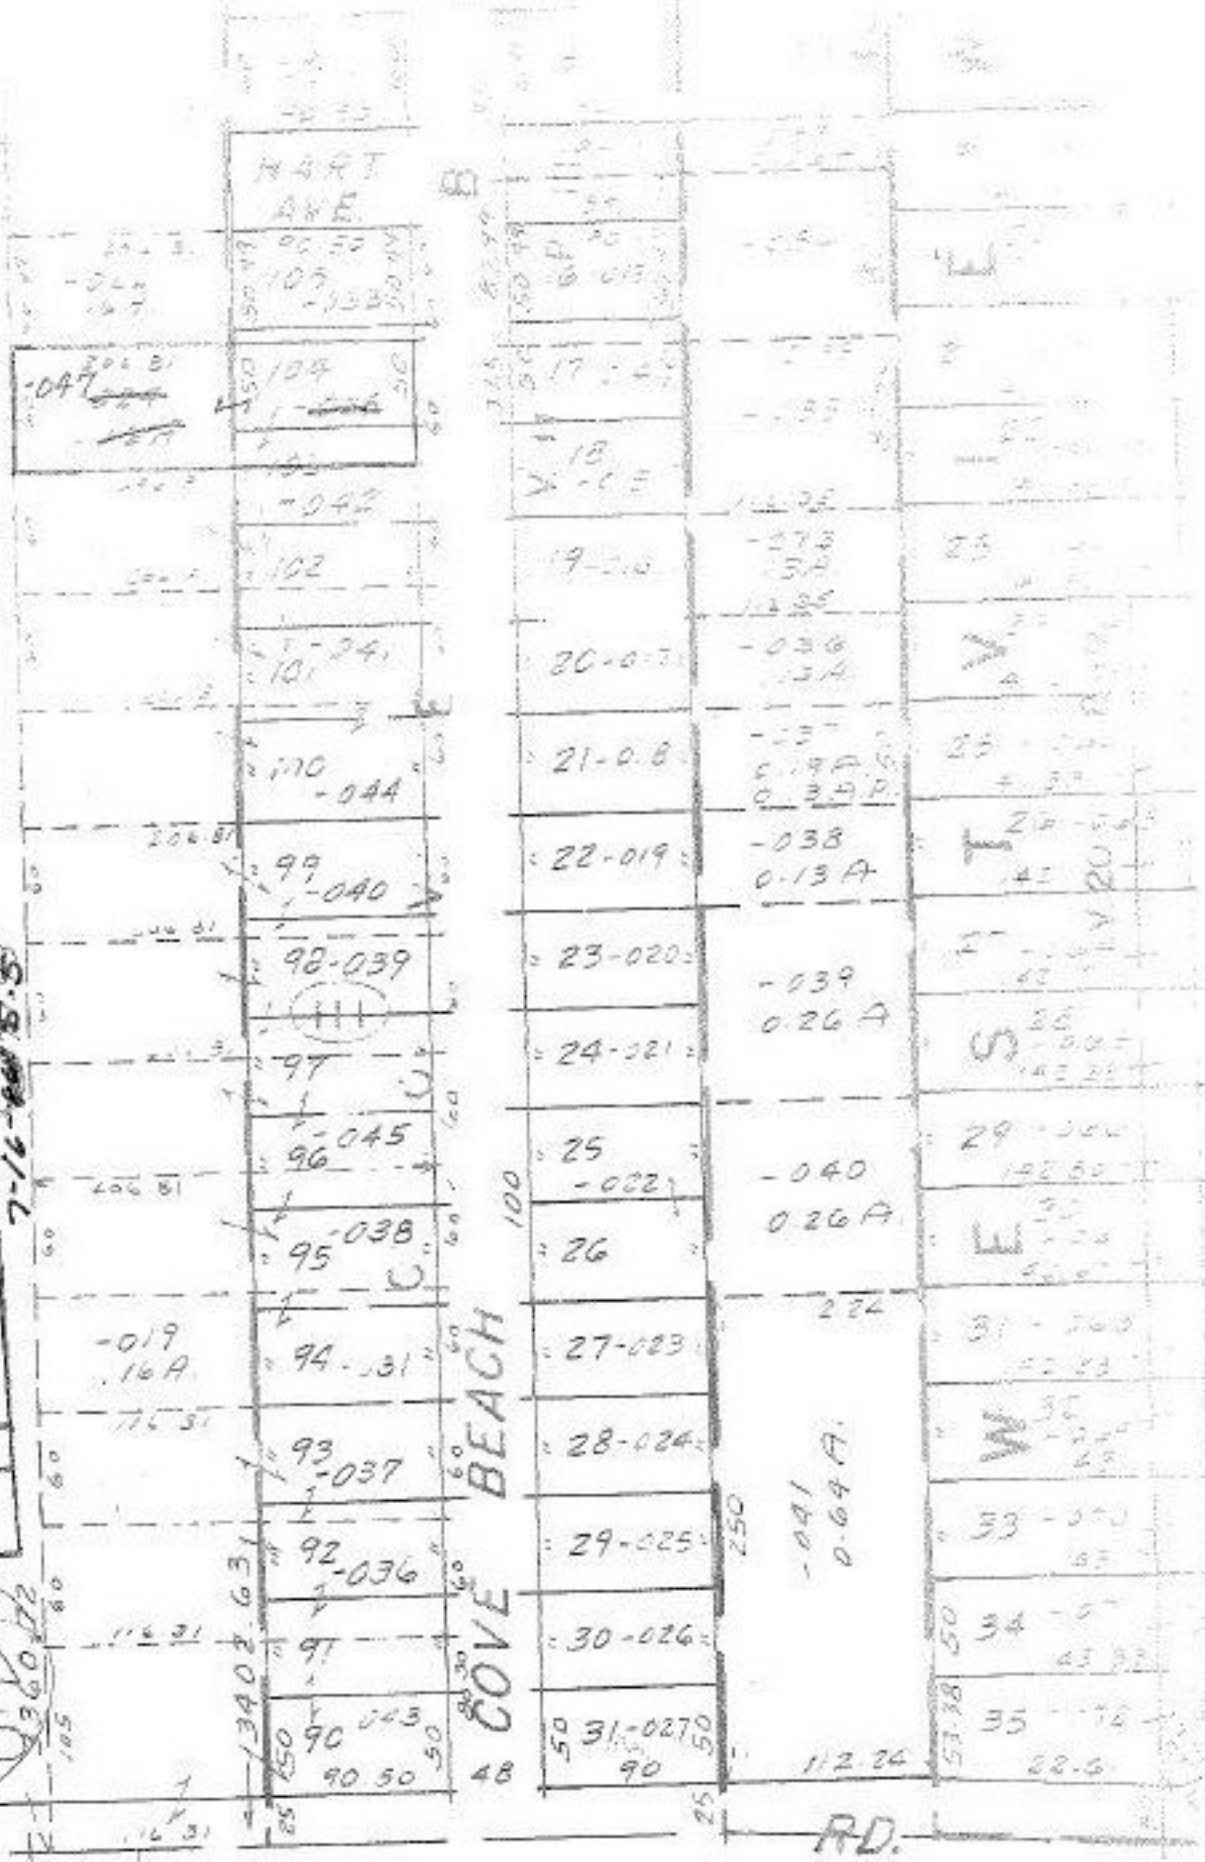

SEE 3-00-033-B

2-14-71