

4974

001
00A

49.02

-001
49.00 A

RD.

X

8


1016.40

27

-003 ✓
-002 ✓
74.52 A
73.52 ✓

6-9-71

JUL 29 1971

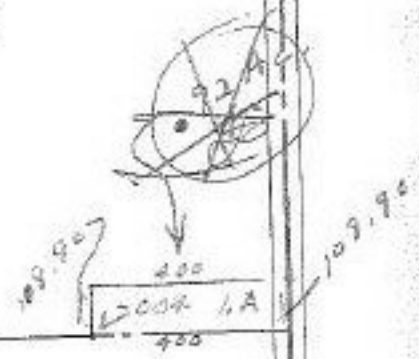

4974

APPROVED
LORAIN CO.
MAP DEPT.
DATE 6/9/71
17-D
BY
R. J. Keillor

7-28-86 L.L.



1203
1215 28A

28