

SEE 3-F

94
35
129

129
40
87

JUL 27 1917

APPROVED
LORAIN CO.
MAP DEPT.


DATE 6/9/17

3-00-095-A

BY

R. V. Keating

Pt. 03.00-083-101-006
Pt. 8.06A.

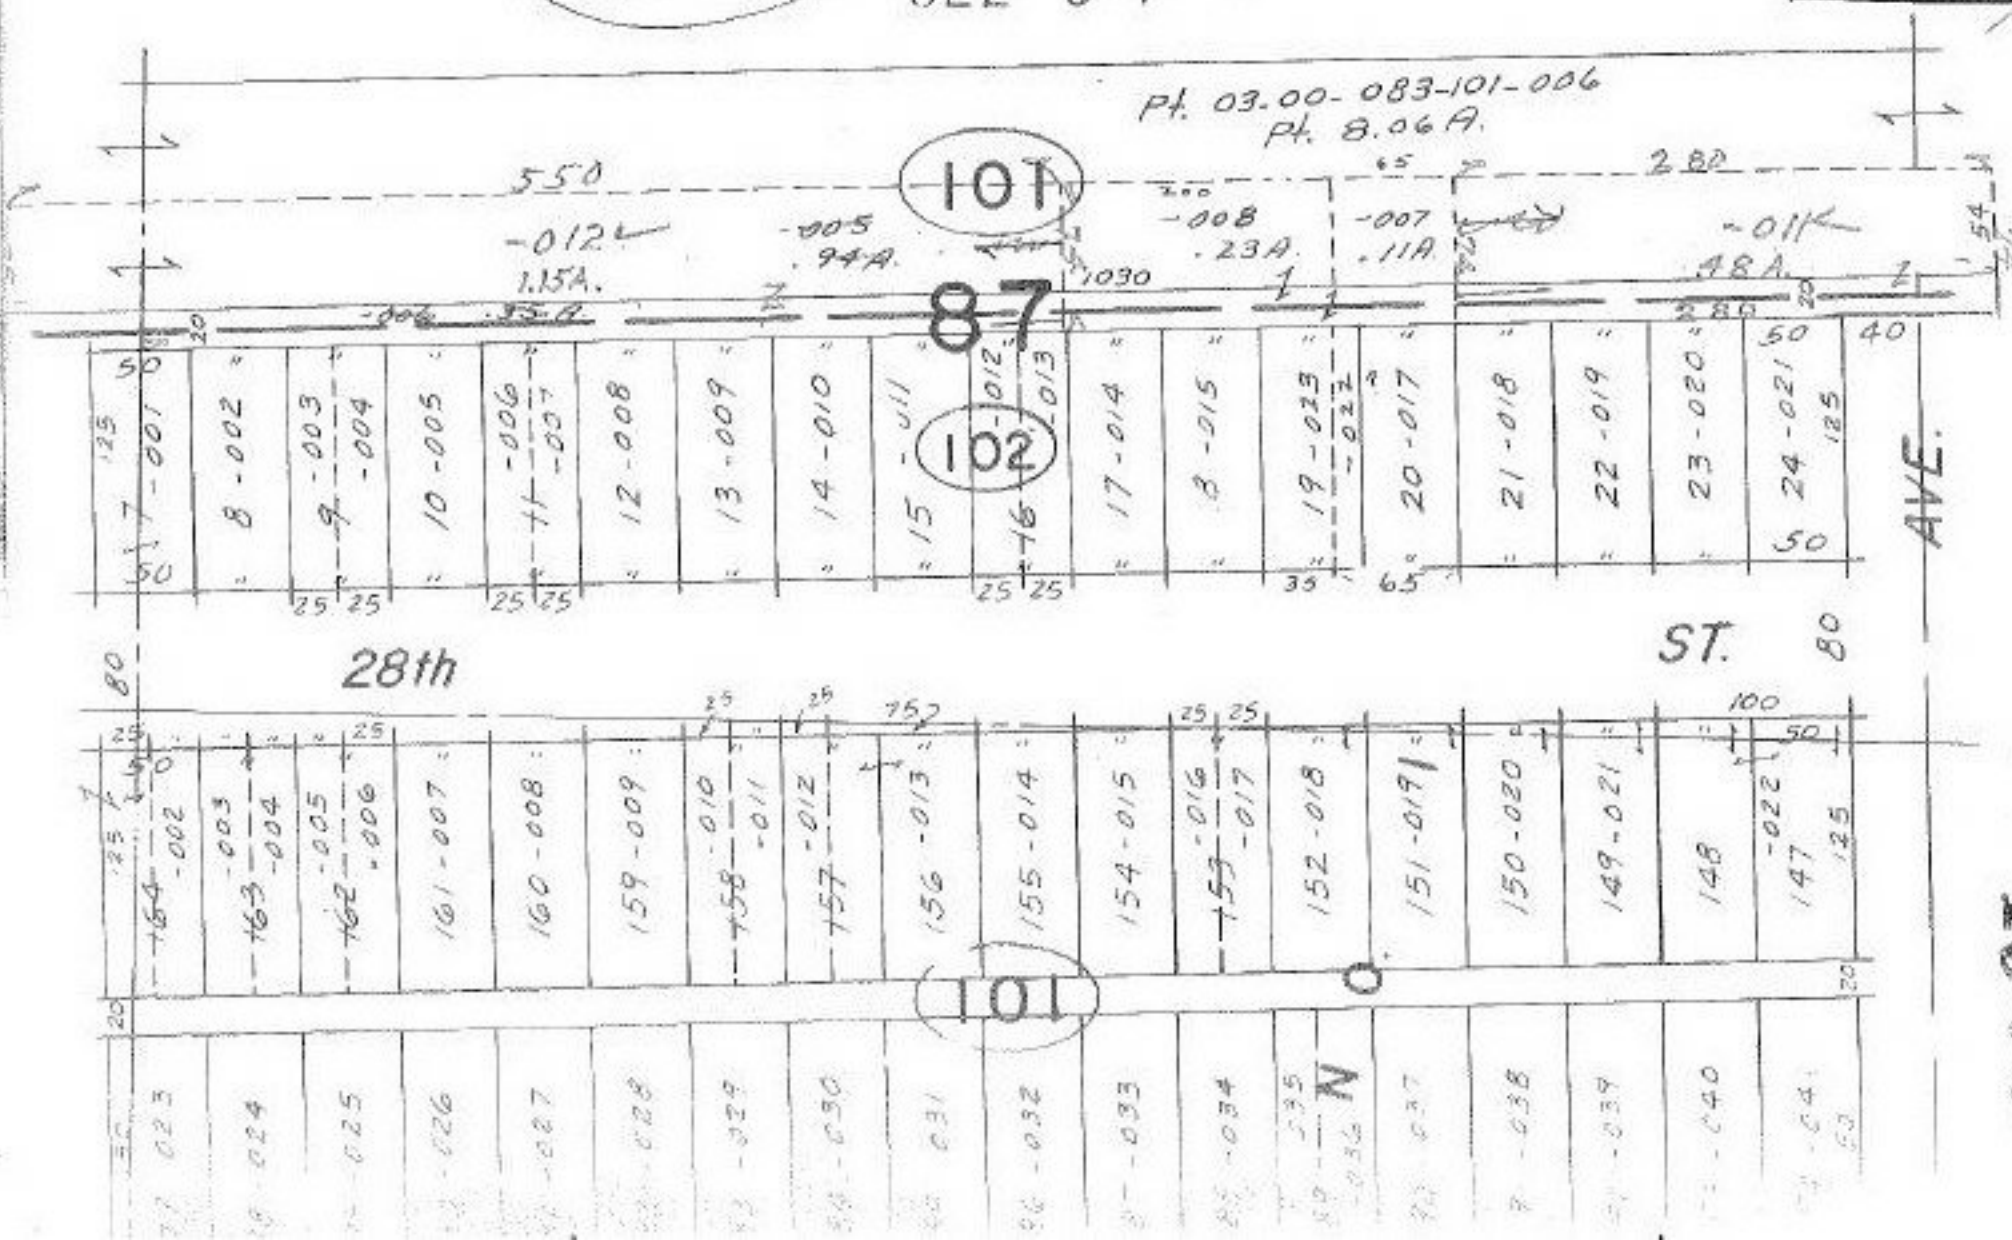

4975