


4977

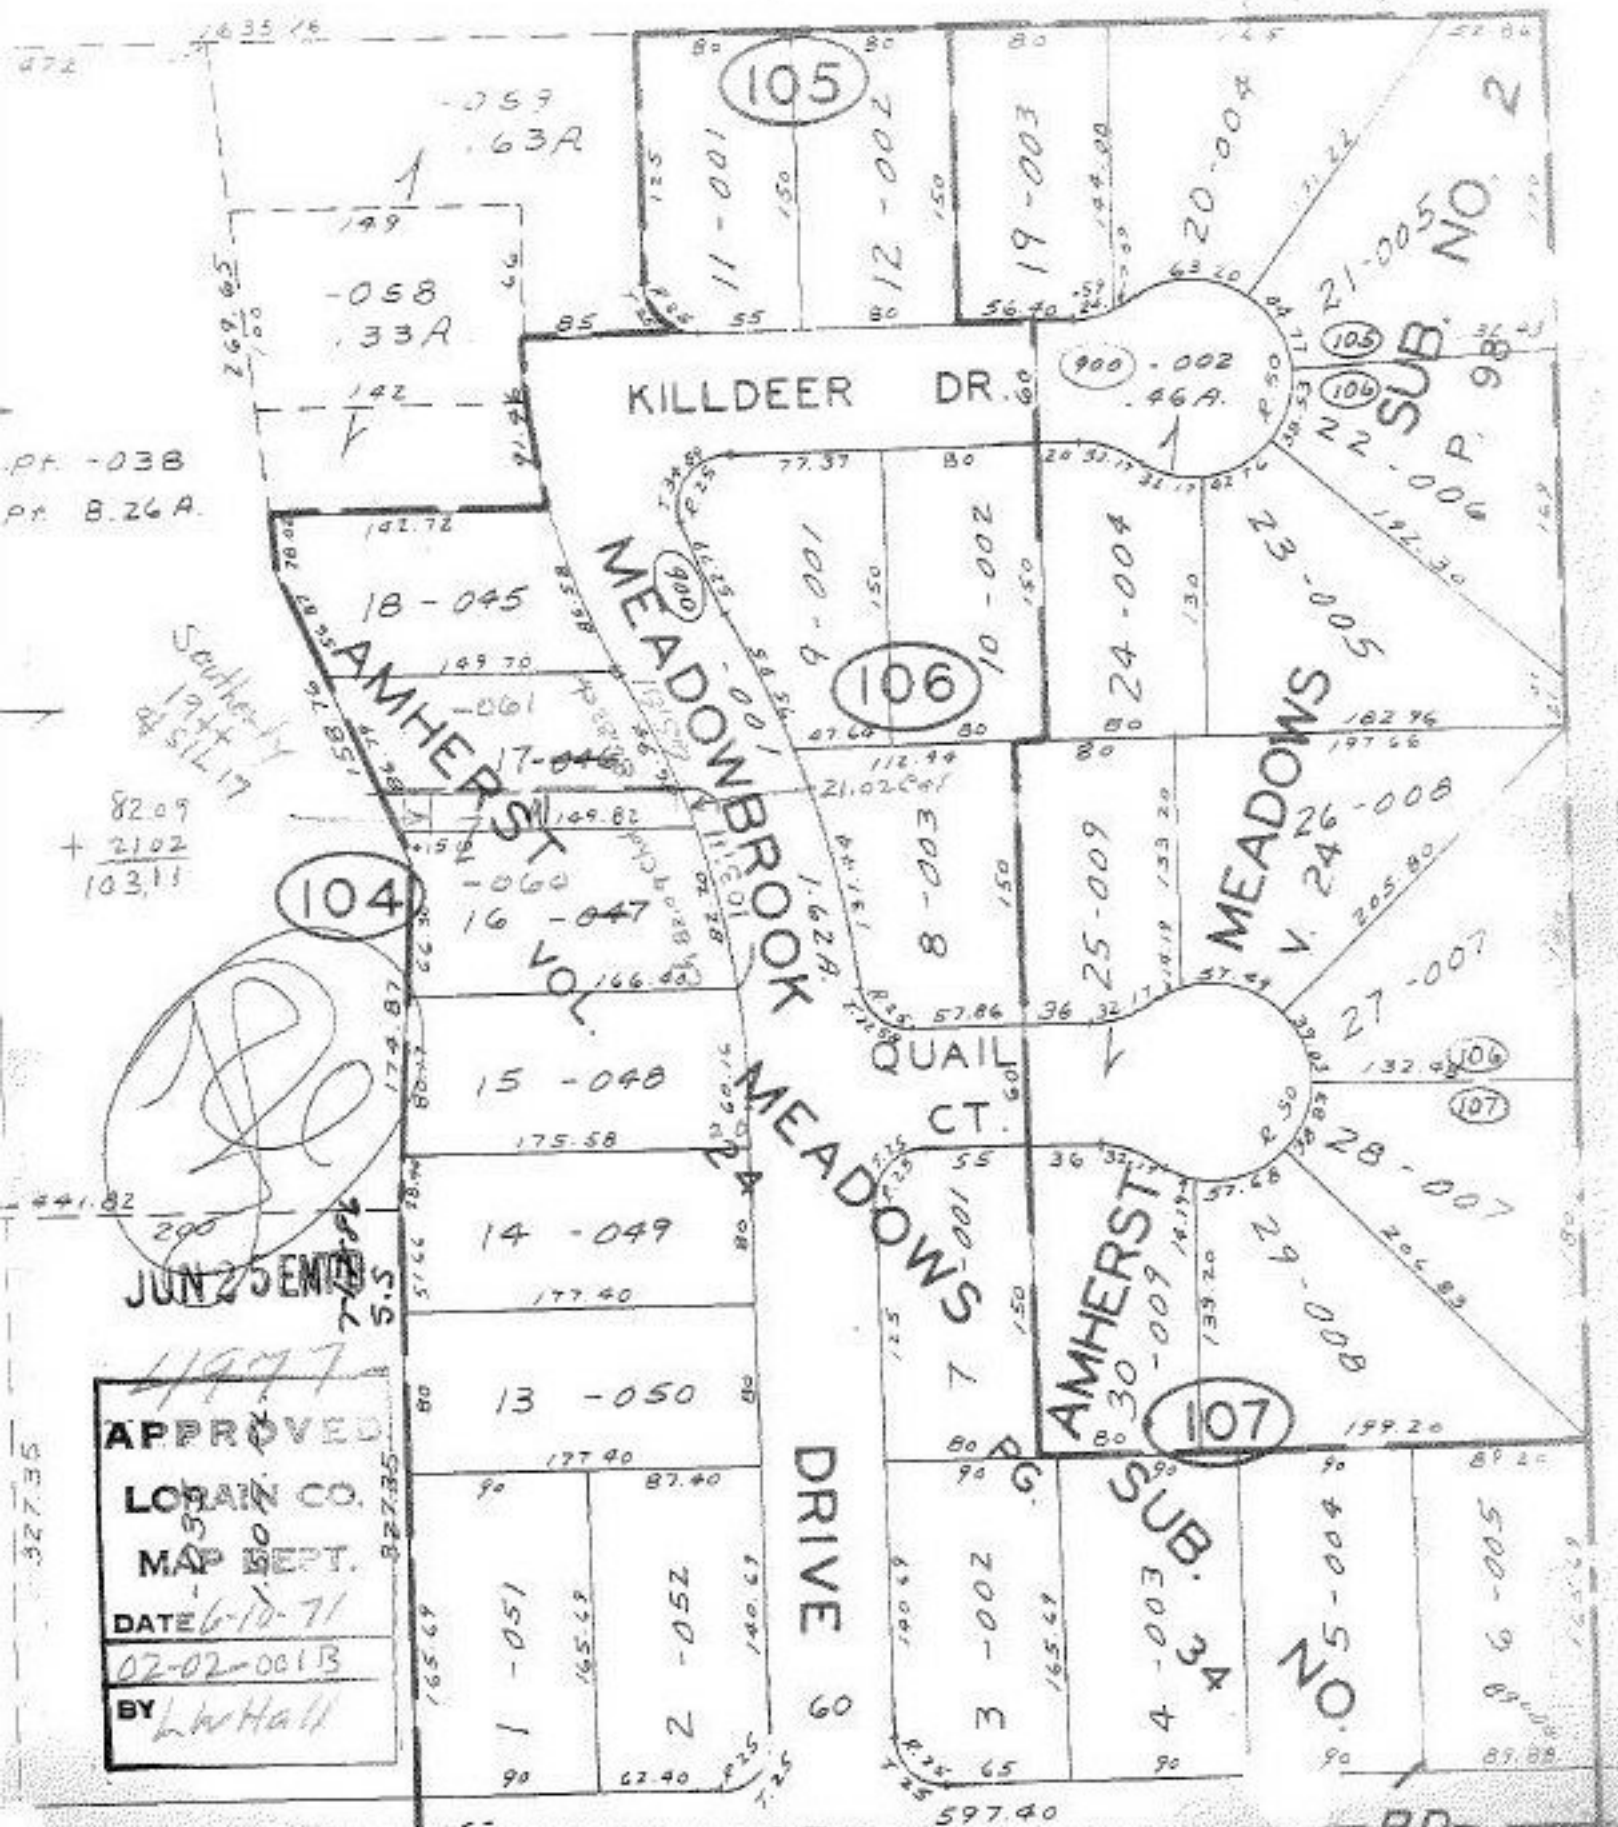

82.09  
+ 21.02  
103.11

4977  
APPROVED  
LORAIN CO.  
MAP DEPT.  
DATE 6-10-71  
02-02-001 B  
BY L. W. Hall

200 COOPER FOSTER PARK RD.

SEE 5-00-021-B

254

6-8-71  
006-B