


4/978

167.54
40
127.54

Separation for Tax Purposes

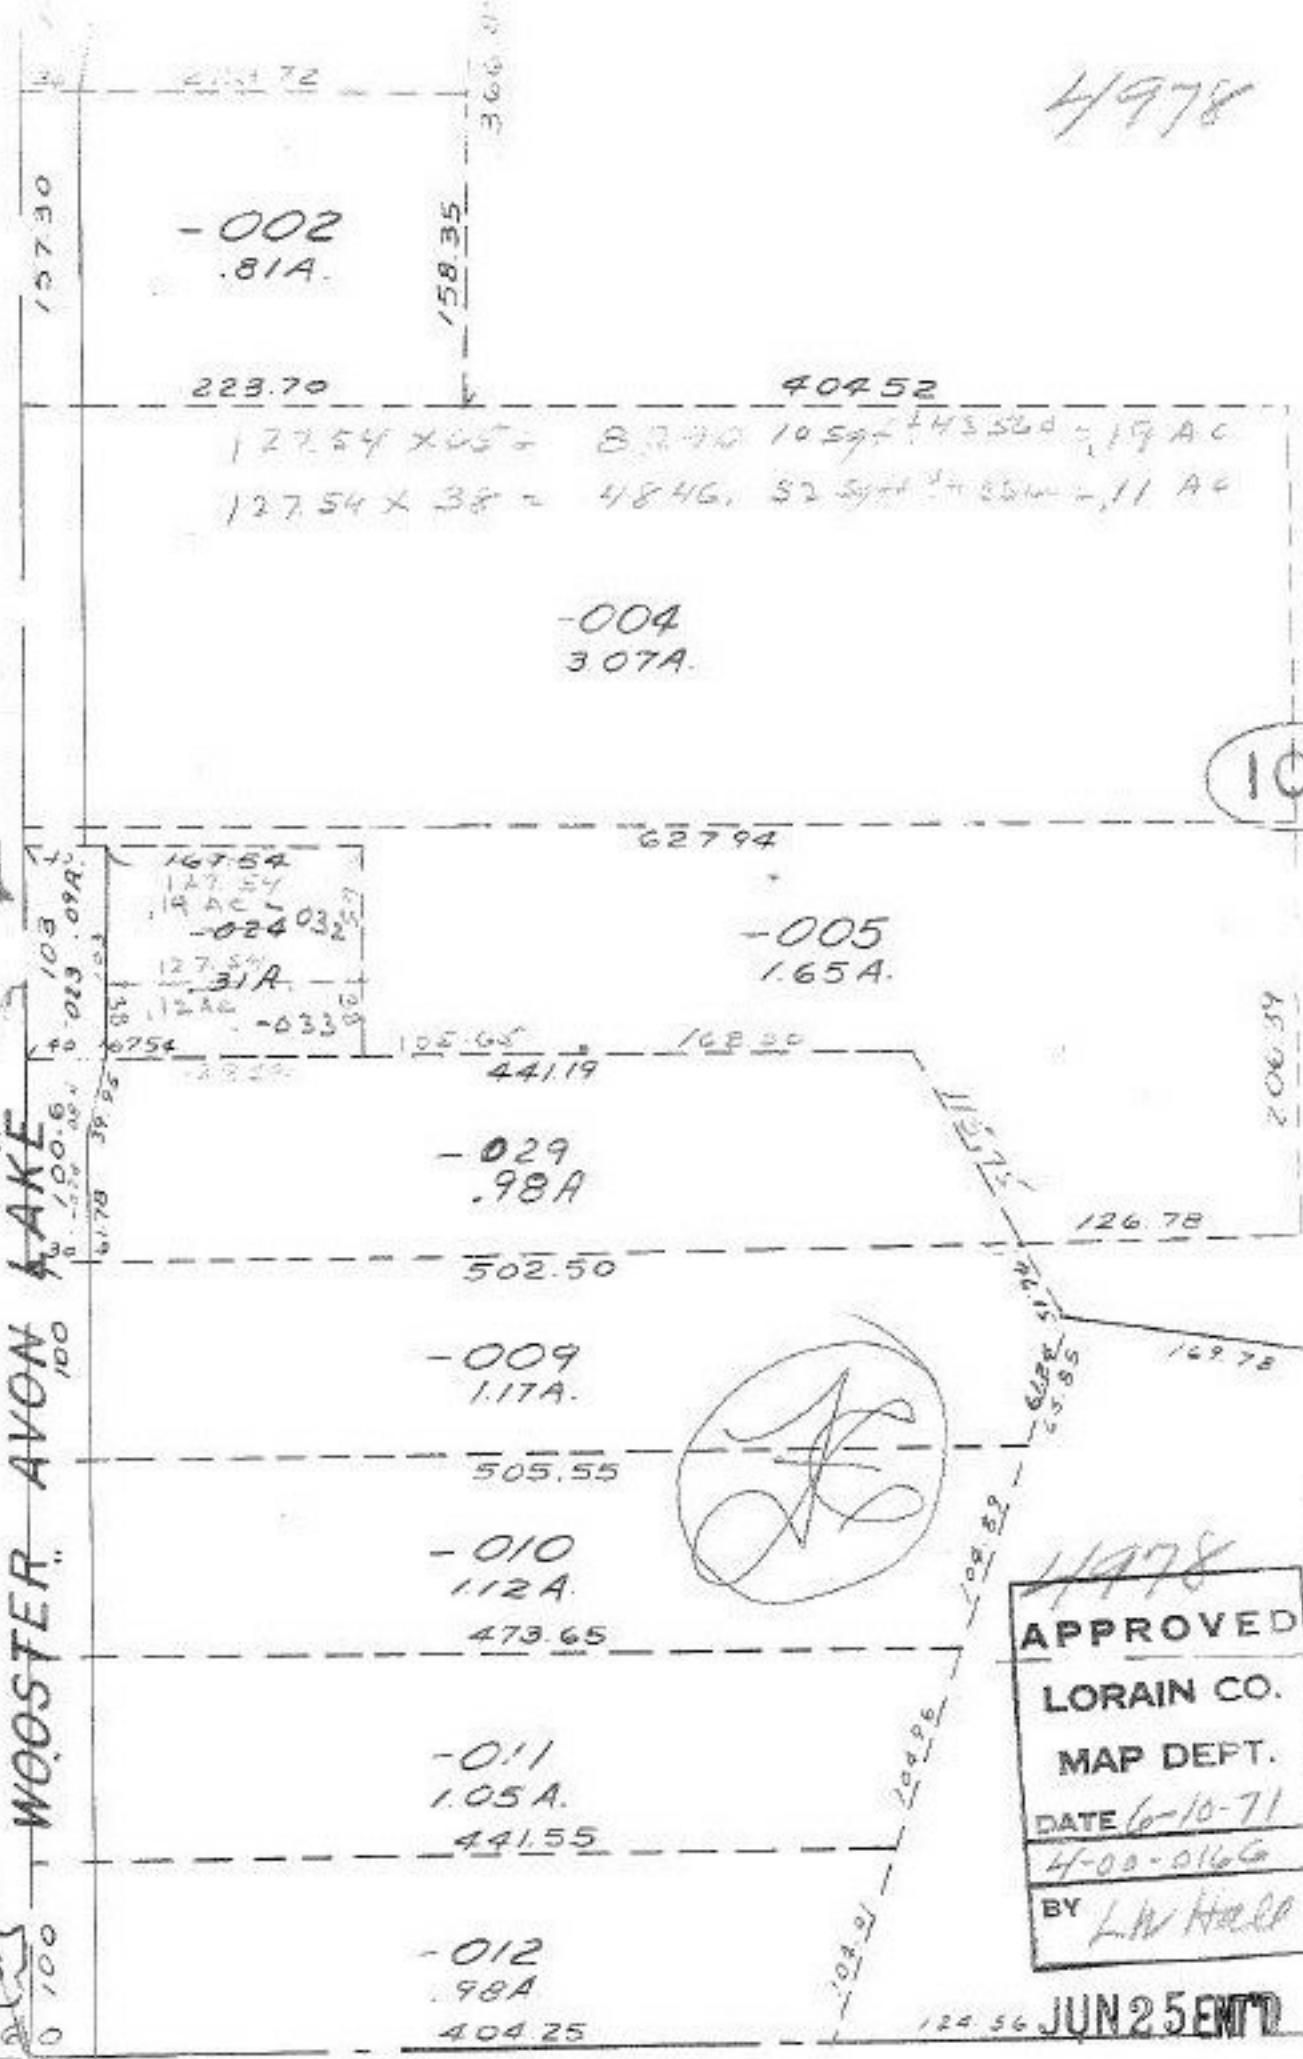

104

(Circled signature)

4/978

APPROVED

LORAIN CO.

MAP DEPT.

DATE 6-10-71

4-00-0166

BY L.W. Hall

7-1886 L.L.

76

4-00-0166

JUN 25 1971

SEE 4-00-01