


4199
5000

JUN 29 1970

APPROVED
LORAIN CO.
MAP DEPT.
DATE 6/17/70
BY [Signature]

(Handwritten signature/initials)

-017
2.00A
Map don't
= scale

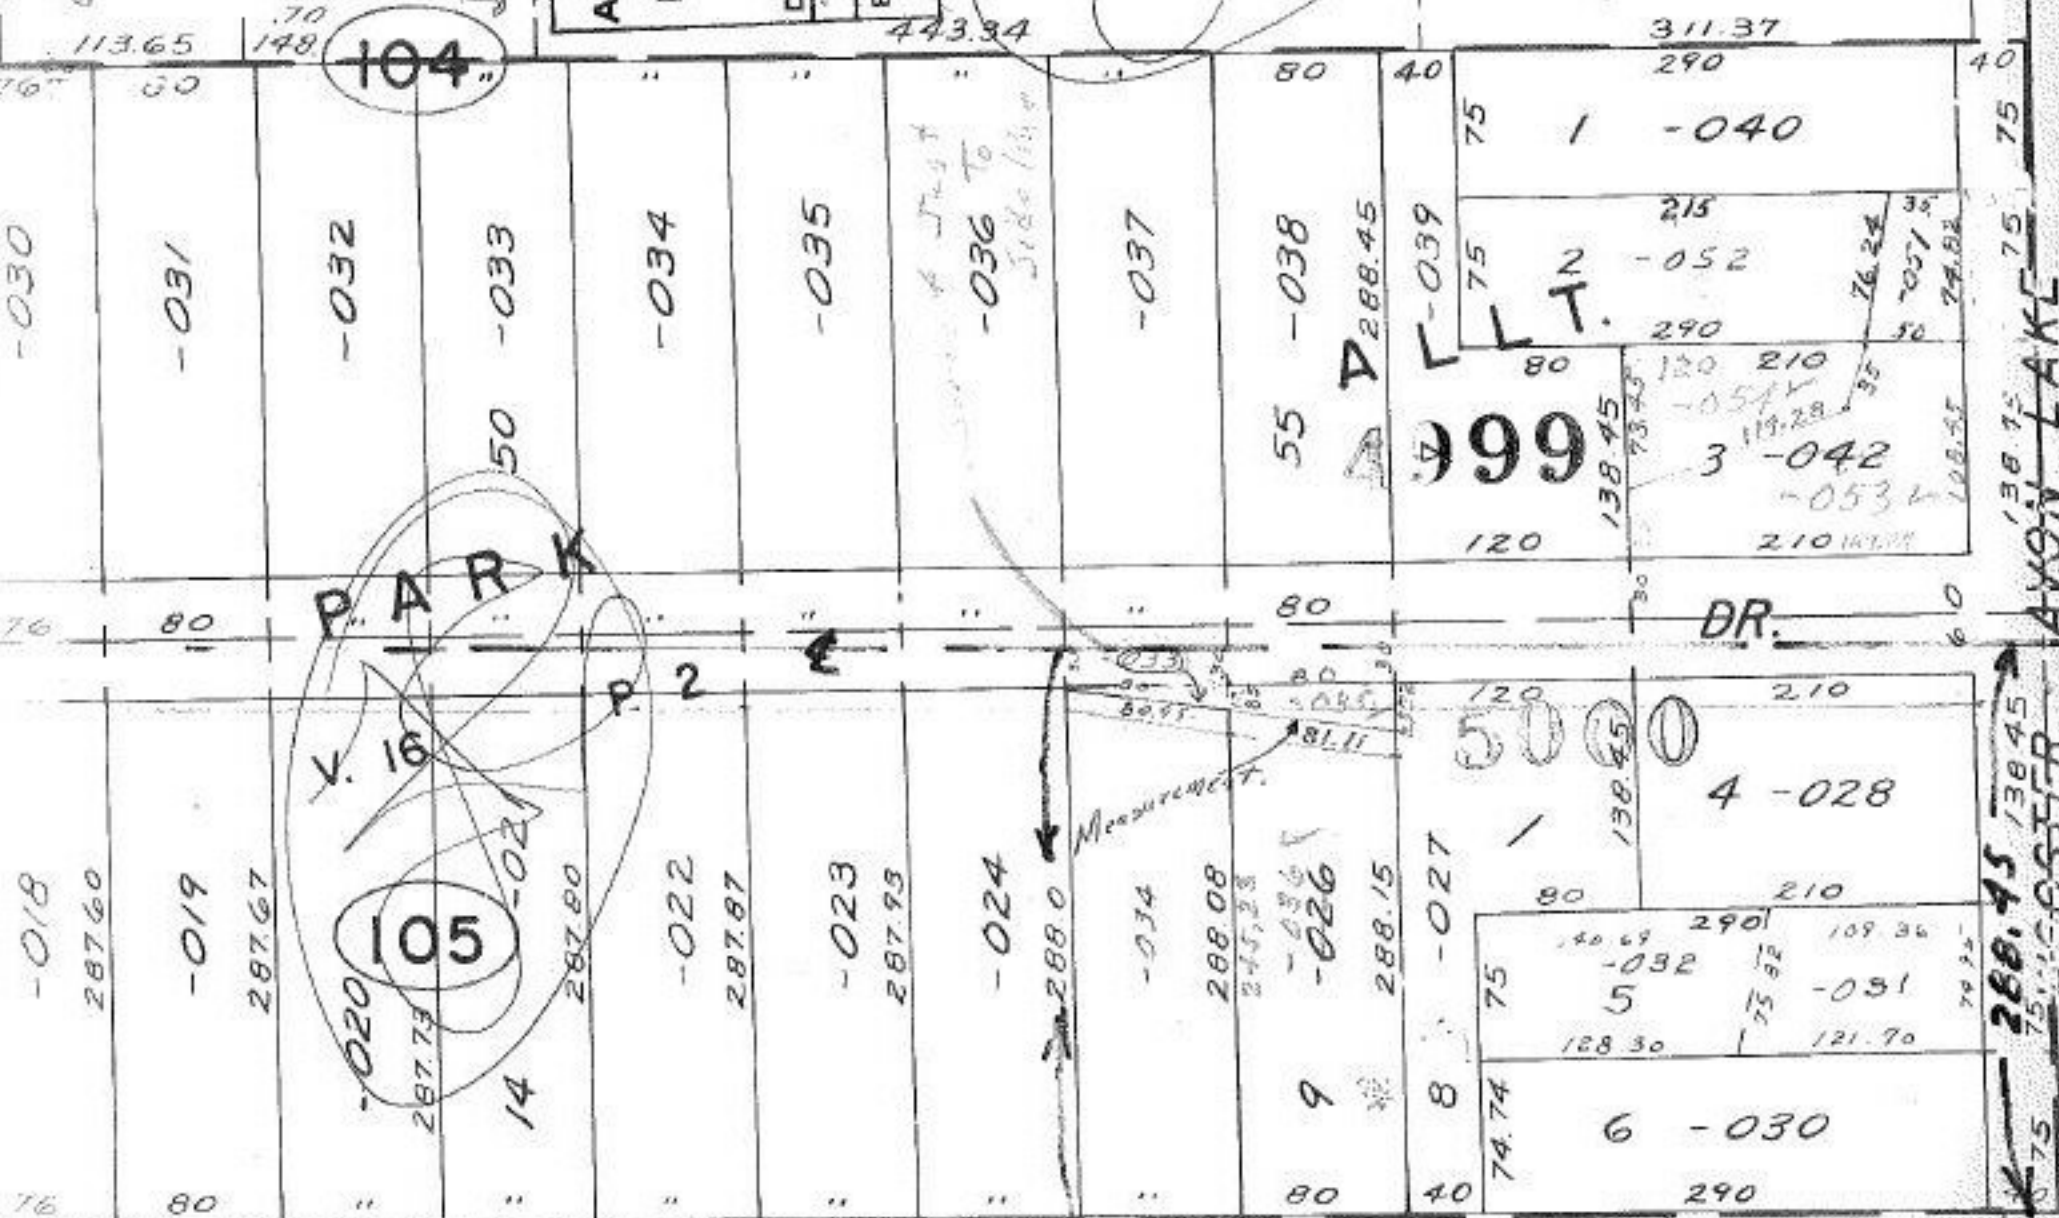

104

105

999

AVON LAKE

COASTER

SF 7-00-025-D

0025
6604