



5041

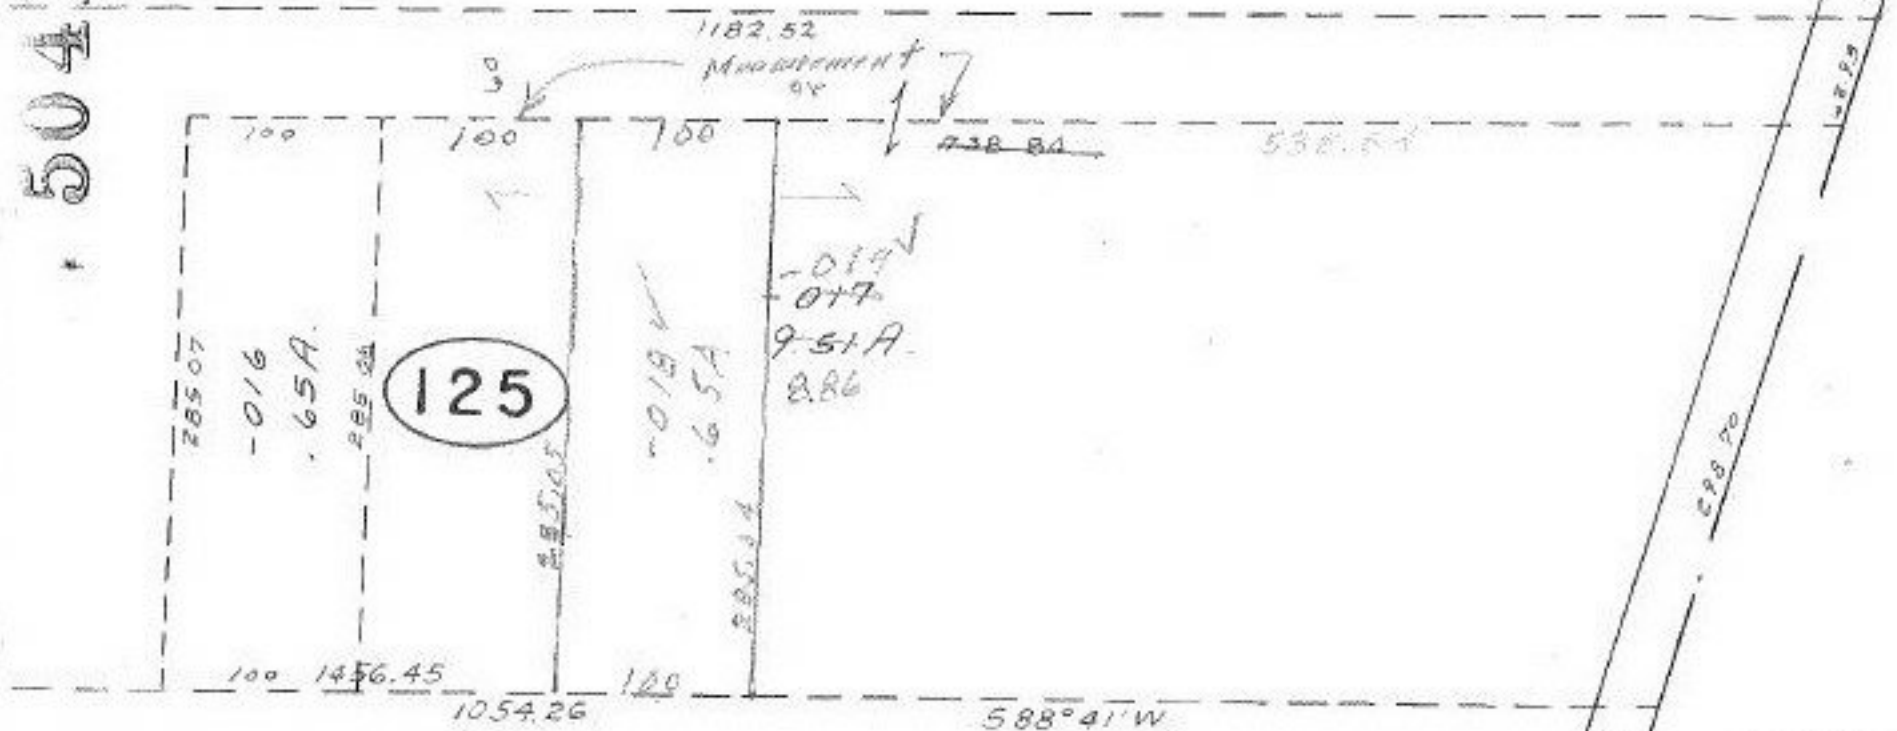

Pt -004  
 Ft 2460A

*(Signature)*  
**5041**

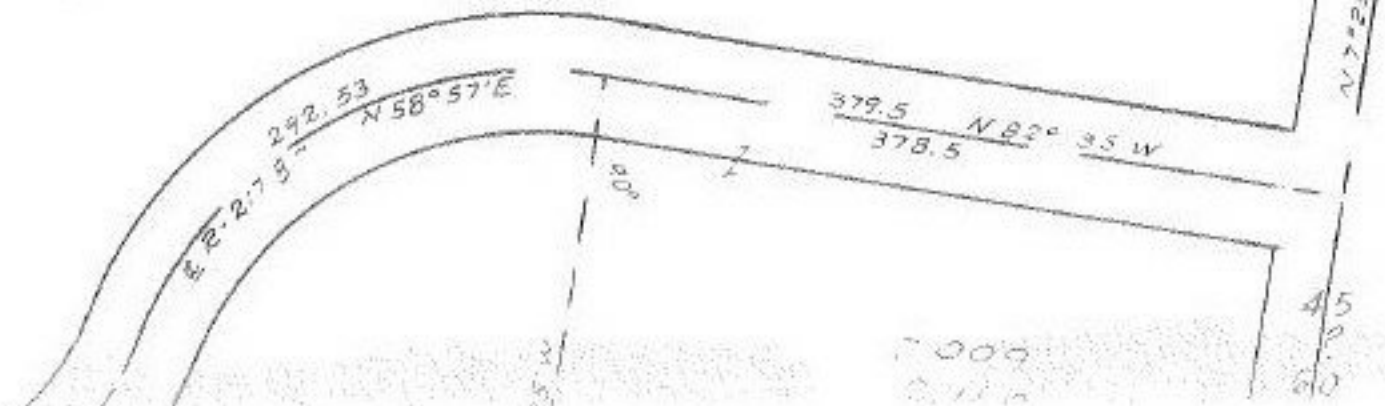

**JUL 16 1970**

APPROVED  
 LORAIN CO.  
 MAP DEPT.  
 DATE 6/29/71  
 18-00-006-F  
 BY  
*Paul Kelling*