


5056

SEE 9-00-080-A



CLEVELAND - OBERLIN

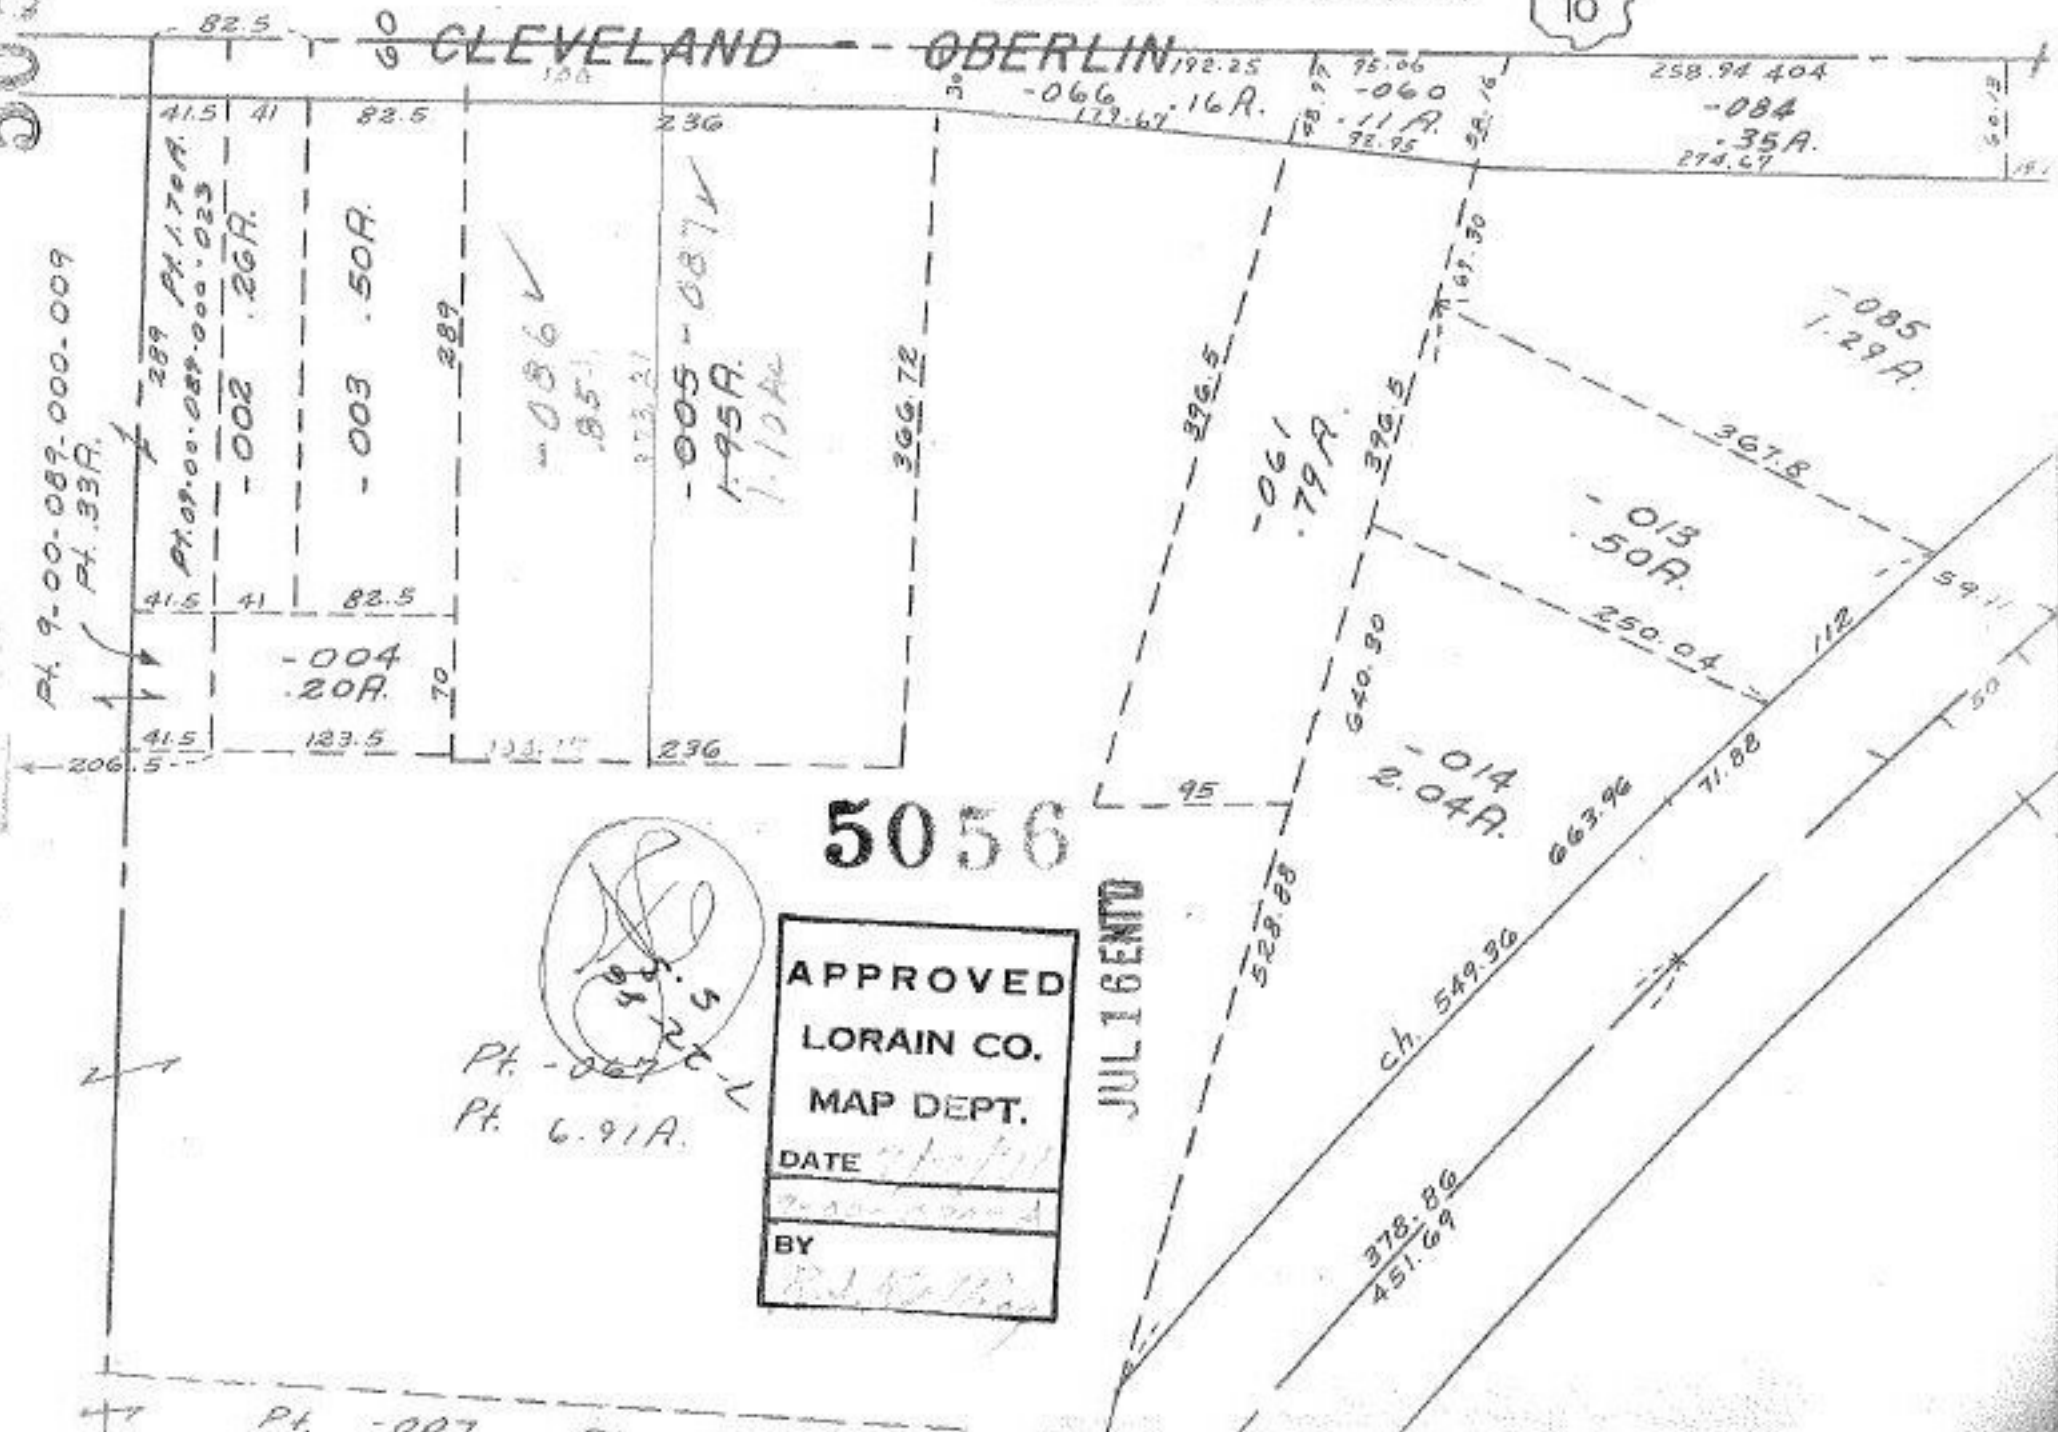

Pt. -007
Pt. 6.91A

5056

APPROVED
LORAIN CO.
MAP DEPT.
DATE 7/16/10
BY [Signature]

JUL 16 2010