


KIPTON - EAST

KIPTON - NICKLE PLATE RD.

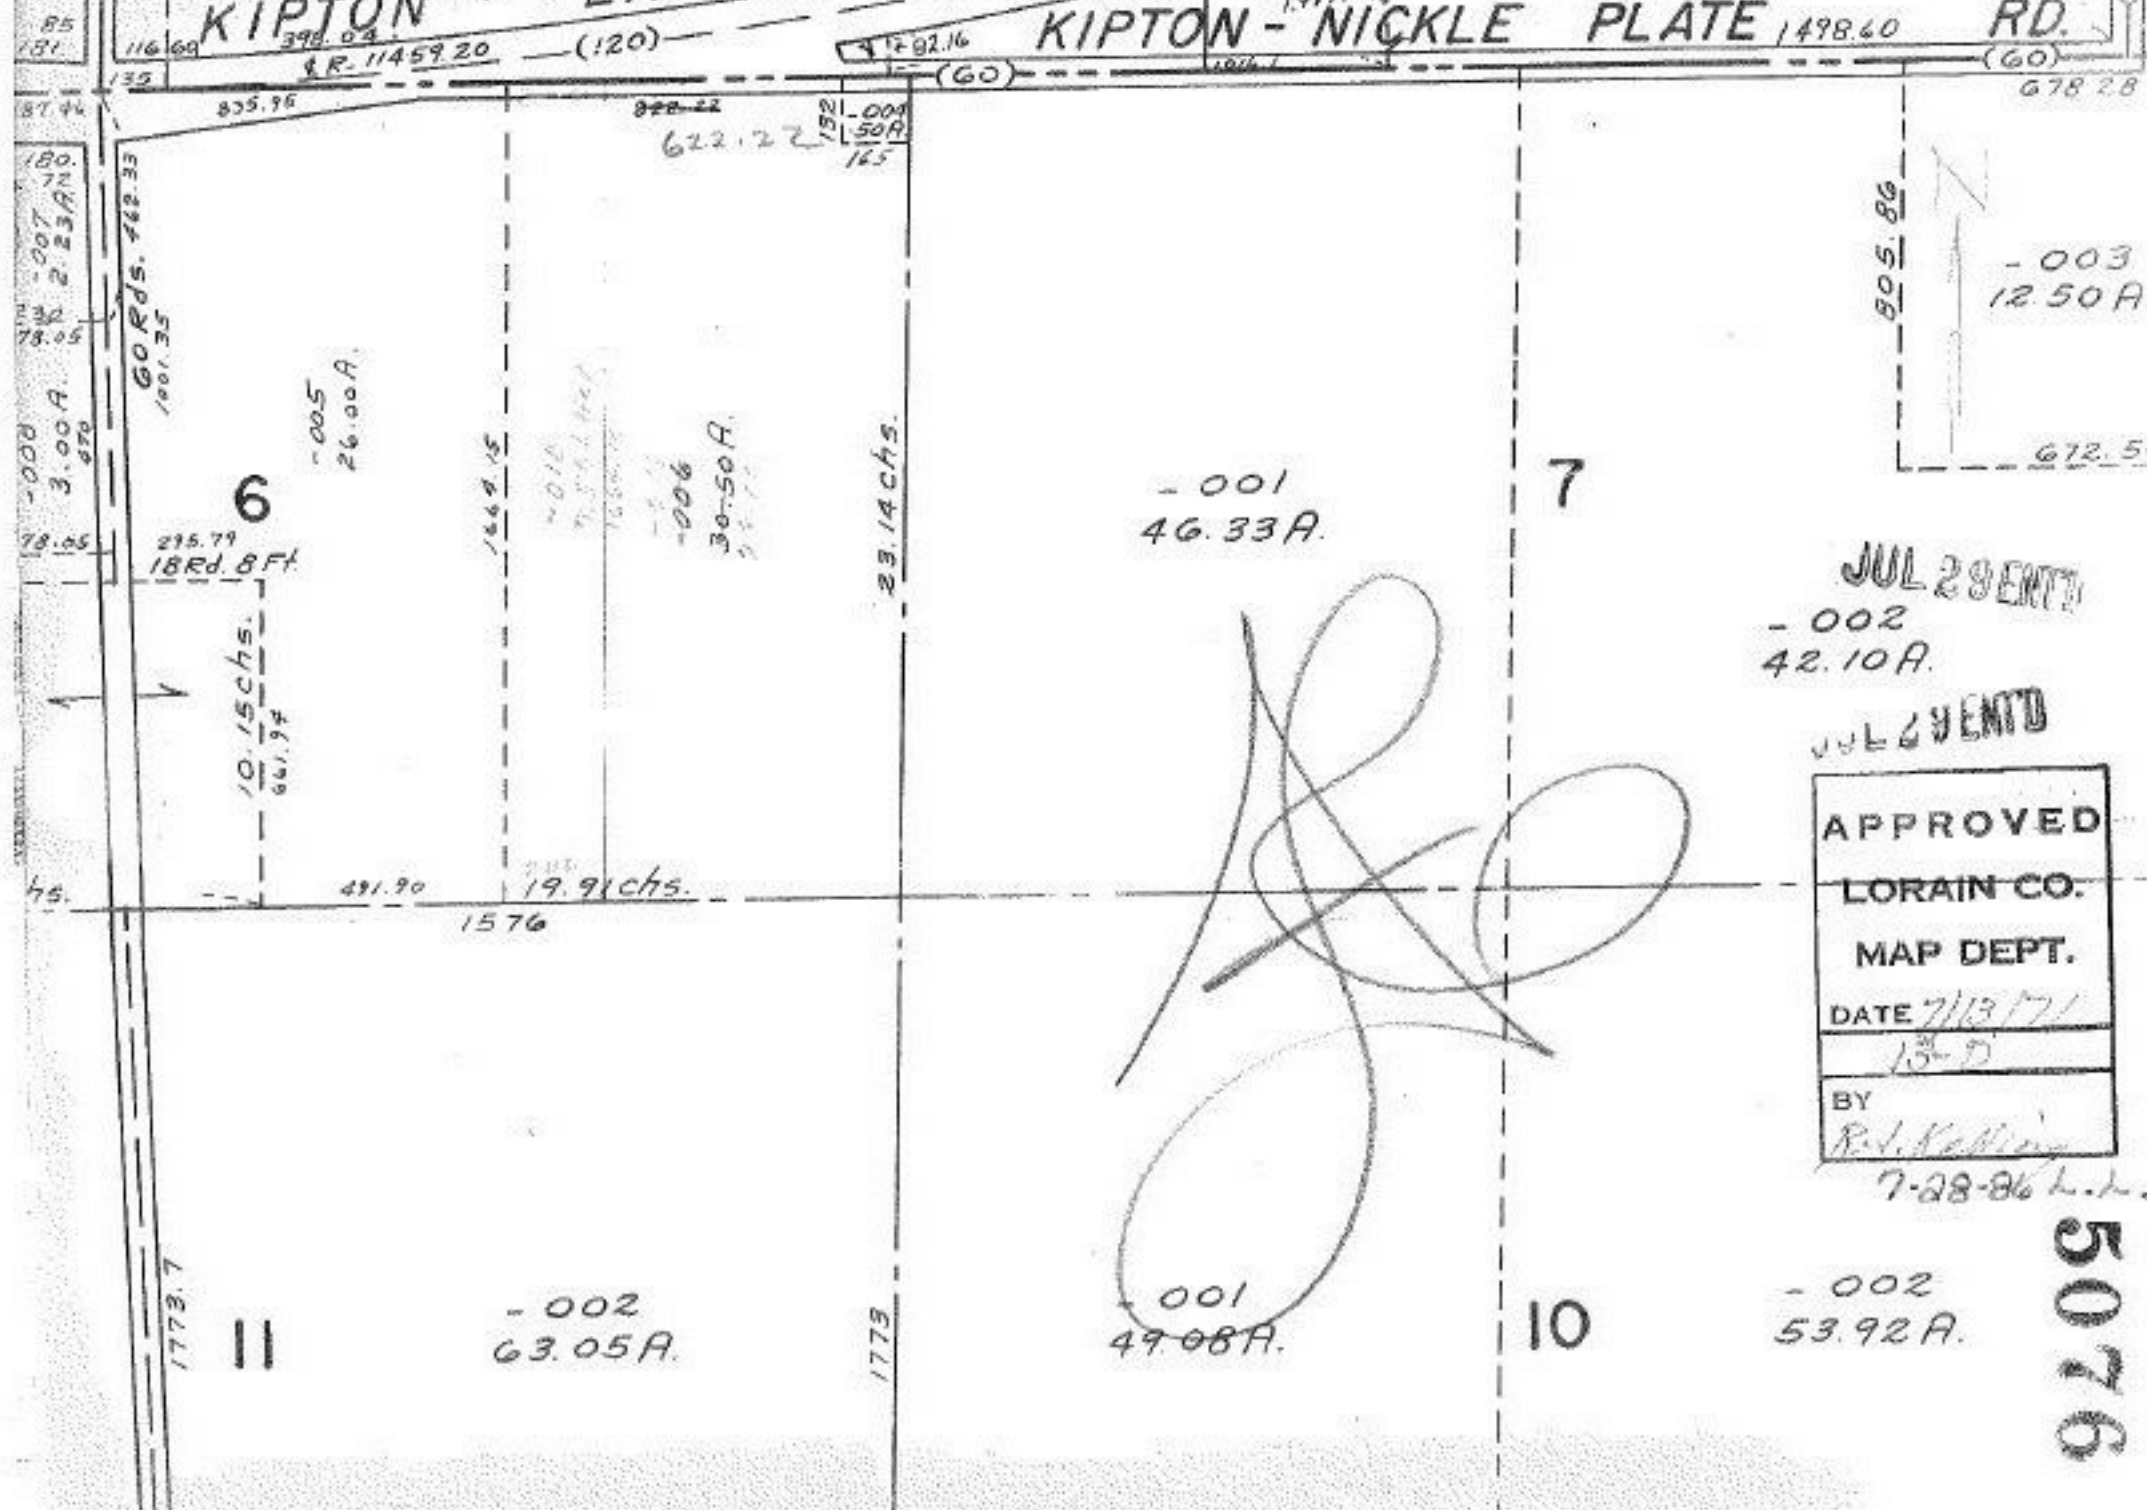

JUL 29 1971
 - 002
 42.10A.

JUL 29 1971

APPROVED
 LORAIN CO.
 MAP DEPT.
 DATE 7/13/71
 13-D
 BY
 R. L. Kelling

7-28-86 h.h.

5076