


5078

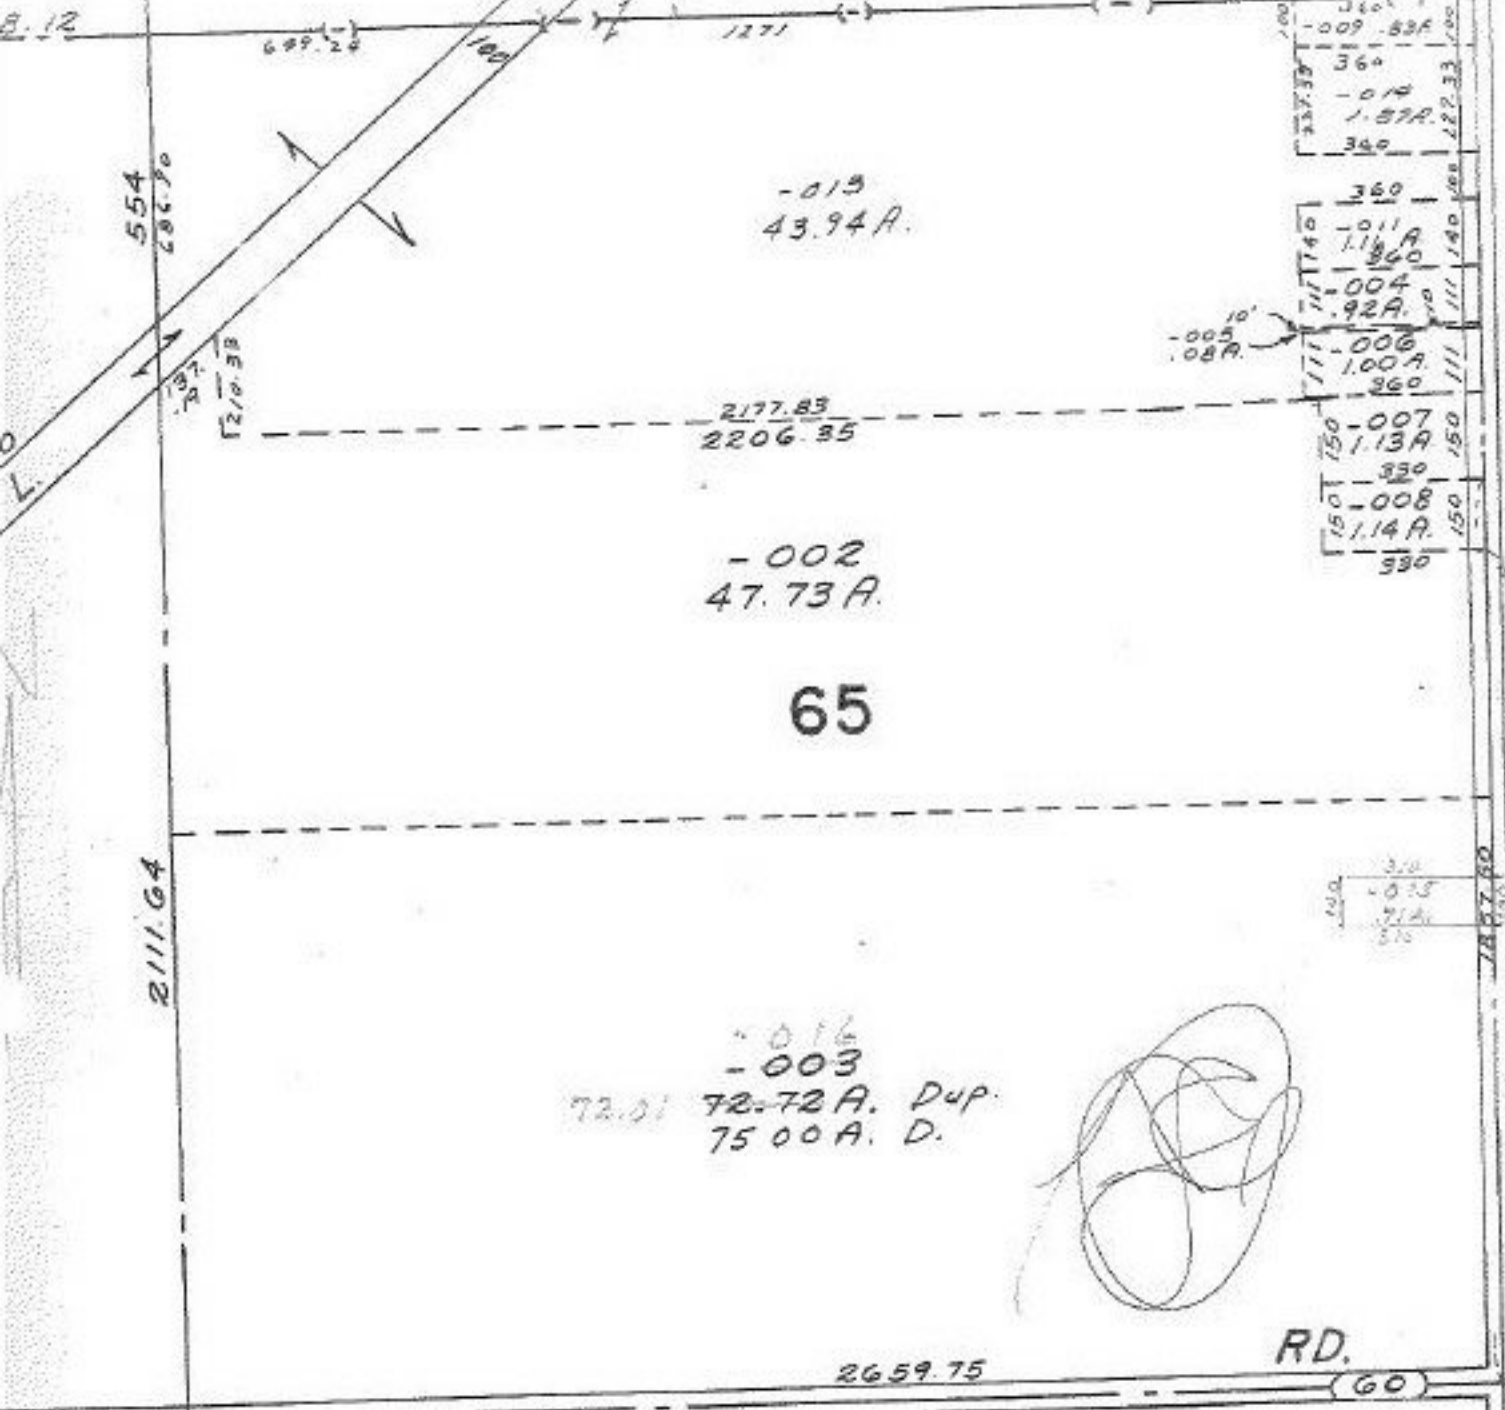

65

JUL 29 1970

5078

-001
100.00 A.

7-28886

APPROVED
LORAIN CO.
MAP DEPT.
DATE 7/13/71
15-F
BY K. Kelling

GRANGE RD.

02
00 A.