

13.30 Ac
51
10.79

-015
2.00A

520
438.44

-016
1.00A

438.44

Eleanor McC
Redman
Executrix - 046 1.44A
Ralph E Albright

~~022~~
022A

735.31

-044
2.77A

718.0


-019
2.44A

024
151A

412.50

1370.43

-018
~~2.007~~
10.79 Cal.
Twp

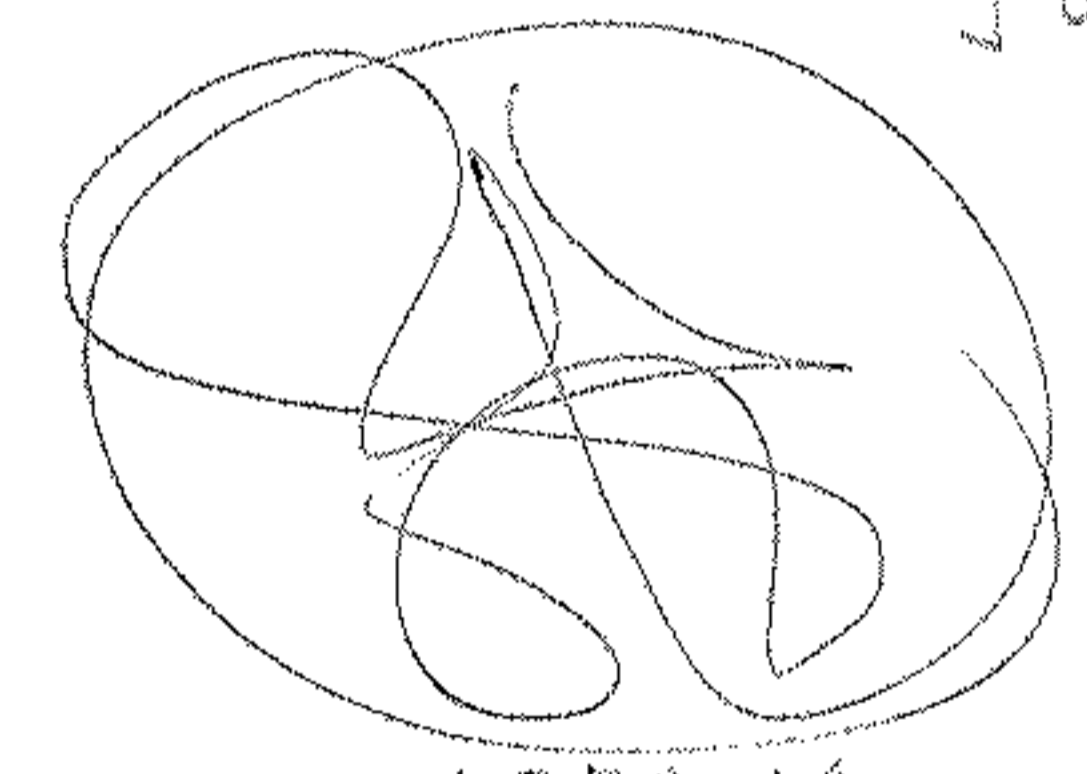

JG & BE
Karnes

1370.10

JG & BE
Karnes

-045
251 Adm
City

430.37

166.52

1524

-020
1.56A

511B

7-18-56 S.S.
511A
APPROVED
LORAIN CO.
MAP DEPT.
DATE 7/23/56
BY [Signature]

AUG 10 1956

511A

