


5137

CLEVELAND OBERLIN

200.0
-10.4
.37A
129.24

- 113
~~- 103~~
~~112.65~~
111.99


LATTASBURG ELYRIA

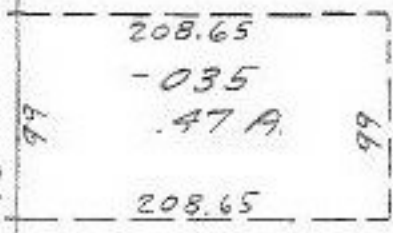


[Handwritten signature]

SEP 13 ENTD

5137
 APPROVED
 LORAIN CO.
 MAP DEPT.
 DATE 7-30-71
 10-00-013C
 BY L. M. HARRIS

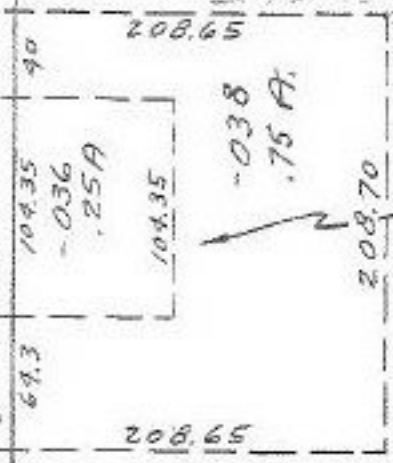

TOWN HALL

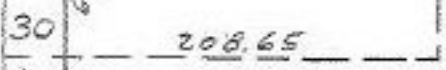

see

SEE 10-00-013

CARLISLE TWP.

SCALE: 1" = 100'

10-00-013C

2 Copies

200.40
208.65
81.7

297.40
21-28-200 2-17-50-1-22

25-1-1-22 1935-2-2-658
046644