

-003
48.00 A.

1159.06
1171.47
1631.52

-004
131.18 A

1792.56

1848.55

4123.0


~~-031~~
~~-006~~
~~49.34 A.~~
47.92

-005
1.00 A

504.22
502.20
505.20



3768.17

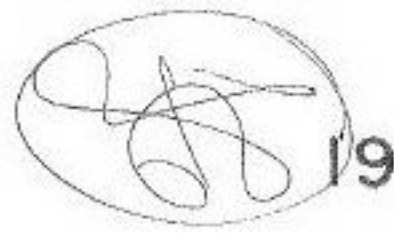

SEP 13 ENT'D

5143
APPROVED
LORAIN CO.
MAP DEPT.
DATE 7-30-71
10 F
BY LWHall

-008
153.97 A.



5143



91° 28'

WEST B