

491.23
43.16

448.07

479.92
43.16

436.76

138


5172

-023
APPROVED
17.43A
LORAIN CO.
MAP DEPT.
DATE 8/6/71
7-00-018-D
BY
R. L. Kelling

7-19-86 L.L.



SEP 9 1971

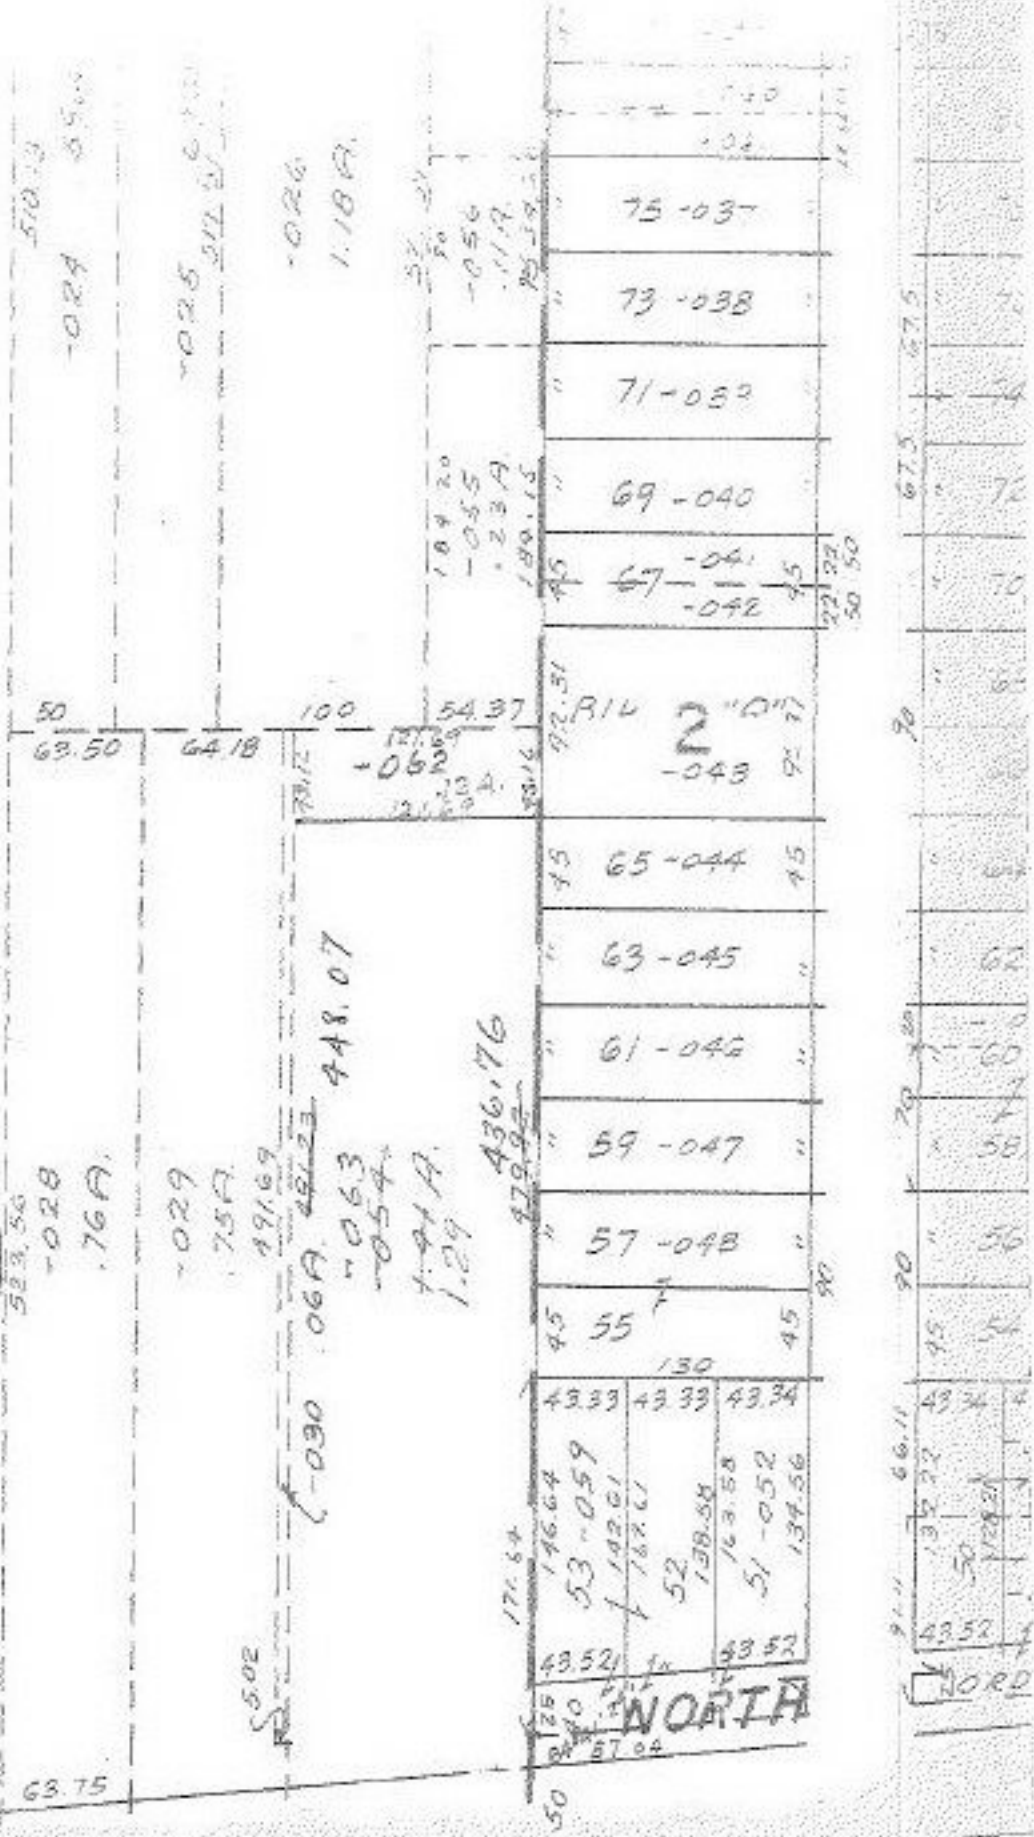

NORTH

SMITH