

5179
5180
6215

APPROVED
LORAIN CO.
MAP DEPT.
DATE 9/10/11
BY R. J. Keating

SEP 9 2011

-002
48.93 A.
14


13
-001
51.88 A.
-013
49.00 A.
45.60

-011
5.52 A.

-010
1.38 A.

-012
1.00 A.

-004
29.62 A.

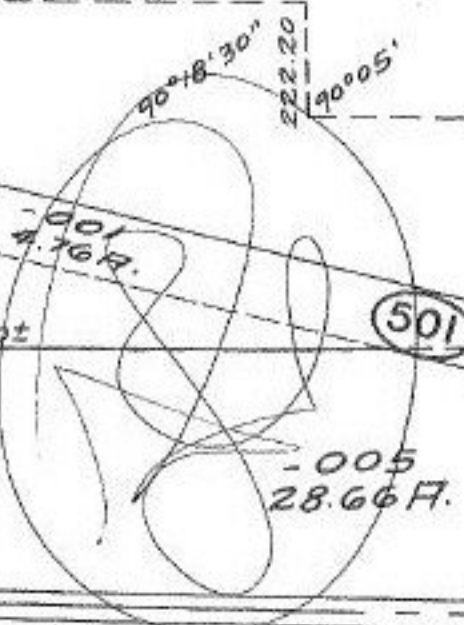


501

501

STATION

SUNNYSIDE RD.

RD.

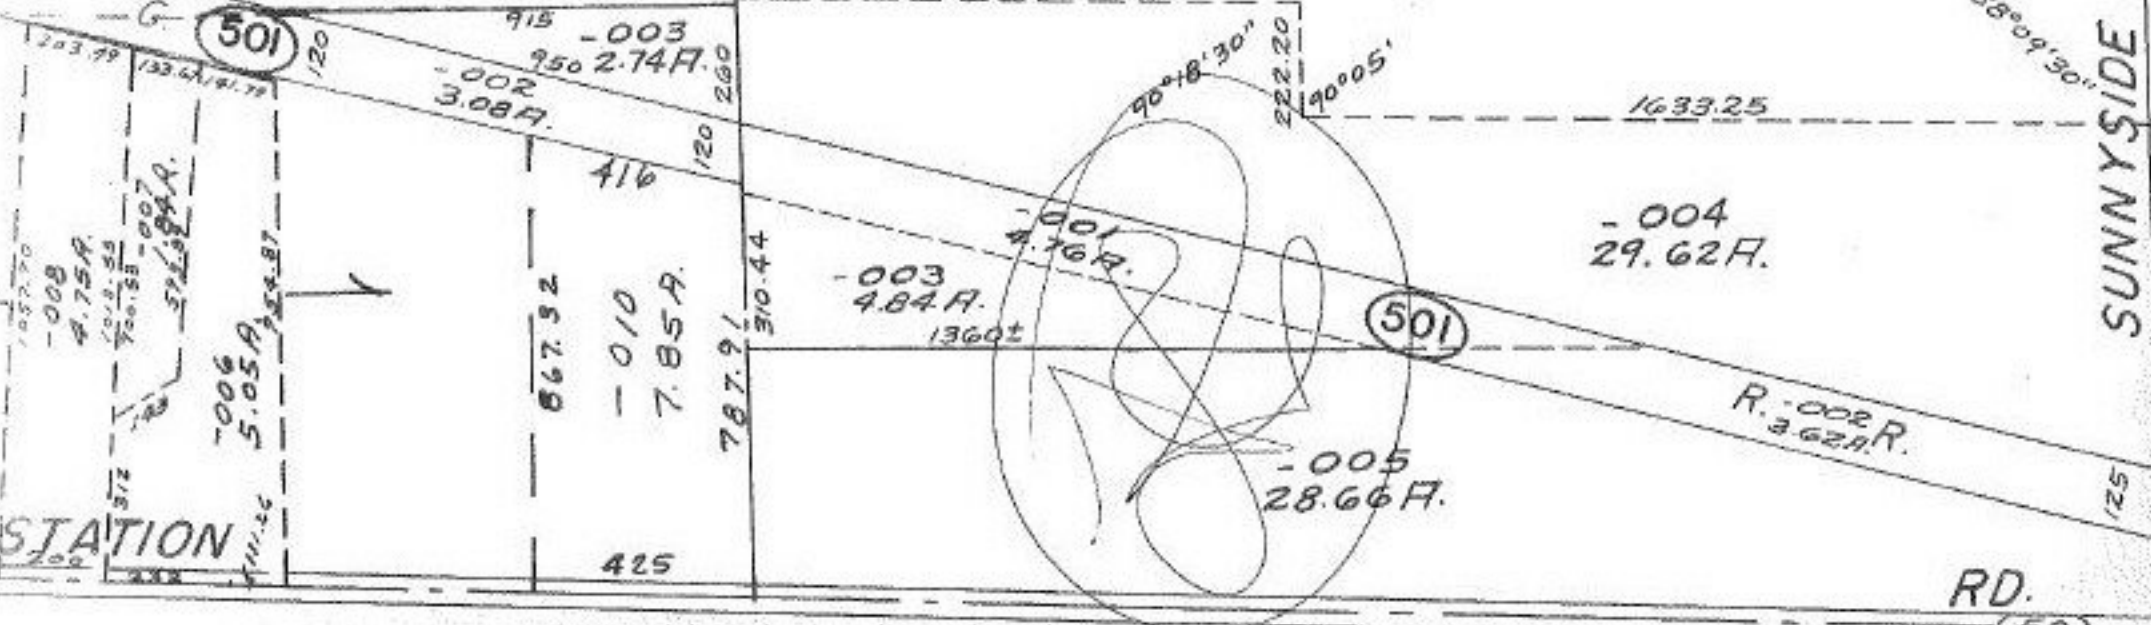

(45)(50)(?)

(50)